PLAT OF SURVEY

-OF-

LOT 64, WHISPERING PINES SECOND ADDITION, BEING PART OF THE NORTHWEST 1/4 OF THESOUTHEAST 1/4 OF SECTION 13, TOWN 2 NORTH, RANGE 15 EAST, IN THE CITY OF DELAVAN, COUNTY OF WALWORTH, STATE OF WISCONSIN.


SURVEY FOR: SOUTHEASTERN HOUSING CORP.

SURVEY ADDRESS: _____ WHISPERING PINES DRIVE

NOTE: MISSING LOT CORNERS TO BE SET BY RSV ENGINEERING AFTER FINAL GRADING AND SIDEWALKS ARE COMPLETED.

LEGEND

O FOUND IRON PIPE

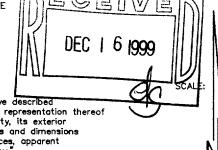

"I hereby certify that I have surveyed the above described property and that the above map is a correct representation thereof and shows the size and location of the property, its exterior boundaries, the location of all visible structures and dimensions of all principal buildings thereon, boundary fences, apparent easements, roadways and encroachments, if any."

"This survey is made for the use of the present owners of the property, and those who purchase, mortgage, or guarantee the title thereta within one year from date hereof."




B.W. SURVEYING

412 N. PINE STREET BURLINGTON, WI 53105 (414)-767-0225

- -- WHISPERING - PINES -DRIVE -

66' WIDE

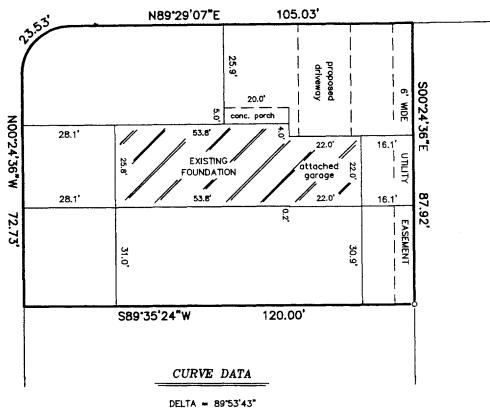

DELTA = 89°53'43"

RADIUS = 15.00'

CHORD = 21.19'

CHD B'INC = NA4°30'15 5"

CHD B'ING = N44'32'15.5"E

ROBERT J. WETZEL

OCTOBER 25, 1999
DATE

JOB NUMBER

THIS IS NOT AN ORIGINAL PRINT UNLESS THIS SEAL IS RED.

5-1777

11-69WX

6181-200