

## PLAT OF SURVEY



OWNER: MILLENNIUM DEVELOPMENT  
PARTNERS II, LLC.  
BUILDER: QUANTUM ENTERPRISES, LLC  
147 GEORGE STREET  
RANDOLPH, WISCONSIN 53956  
(920) 326-4139  
(920) 326-4138 (FAX)

BUILDING 10 OF THE FIELDS OF DELAVAN, BEING A REDIVISION OF LOT 1  
OF CERTIFIED SURVEY MAP NO. 2577, BEING PART OF THE SOUTHWEST  
QUARTER (SW 1/4) OF SECTION 13, TOWN 2 NORTH, RANGE 15 EAST  
CITY OF DELAVAN, WALWORTH COUNTY, WISCONSIN.

EXISTING TOP OF FOUNDATION ELEVATION: 947.62



NOTE: EXPOSE SANITARY SEWER LATERAL BEFORE CONSTRUCTION TO VERIFY GRAVITY FLOW  
FROM THE BASEMENT.

REFERENCE BEARING: ALL BEARINGS ARE REFERENCED TO GRID NORTH OF THE WISCONSIN STATE PLANE COORDINATE  
SYSTEM SOUTH ZONE.

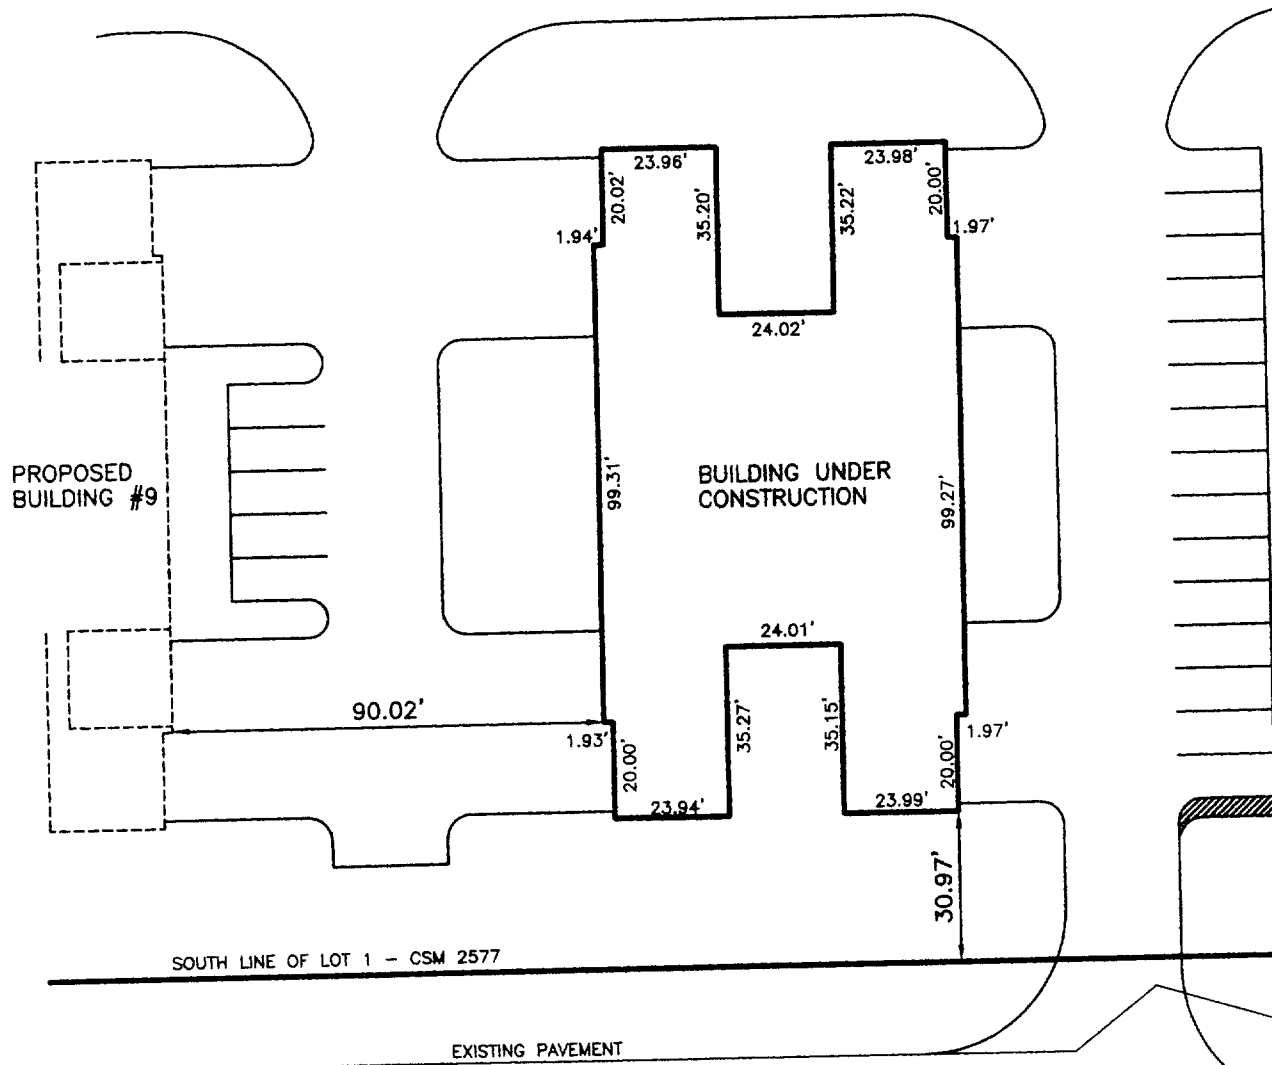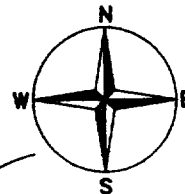


PLAN DATED: FEBRUARY 2, 1999  
FILE NO.: D:\9800\98201  
PLAN SCALE: 1" = 40'

STATE OF WISCONSIN }  
COUNTY OF JEFFERSON } SS.

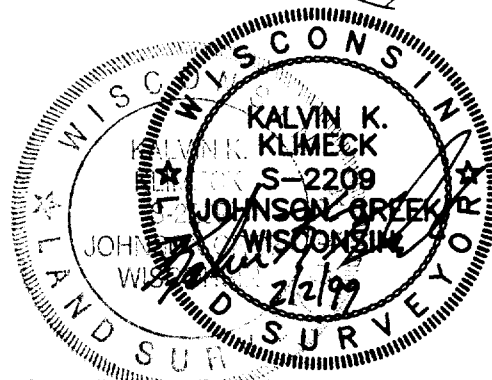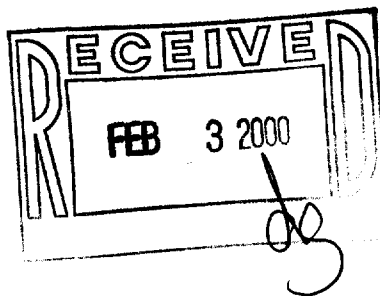

WE, PIONEER ENGINEERING & SURVEYING, DO HEREBY CERTIFY THAT WE HAVE MADE THIS SURVEY AND THAT  
THE INFORMATION AS SHOWN ON THE ABOVE PLAT OF SURVEY IS TRUE AND CORRECT REPRESENTATION THEREOF.

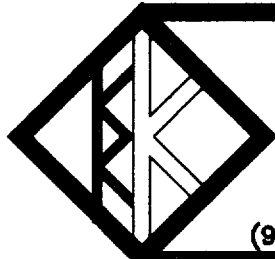


**PIONEER ENGINEERING  
AND SURVEYING**

CONSULTANTS IN SUBDIVISIONS  
AND COMMERCIAL DEVELOPMENTS

3902 C.T.H. "B"

JOHNSON CREEK, WI. 53038

(920) 699 - 3330 FAX: 699 - 3332

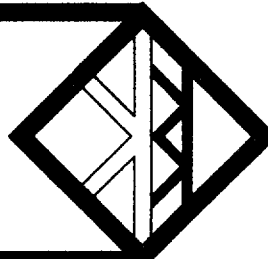

## PLAT OF SURVEY

OWNER: MILLENNIUM DEVELOPMENT  
PARTNERS II, LLC.  
BUILDER: QUANTUM ENTERPRISES, LLC  
147 GEORGE STREET  
RANDOLPH, WISCONSIN 53956  
(920) 326-4139  
(920) 326-4138 (FAX)



BUILDING 10 OF THE FIELDS OF DELAVAN, BEING A REDVISION OF LOT 1  
OF CERTIFIED SURVEY MAP NO. 2577, BEING PART OF THE SOUTHWEST  
QUARTER (SW 1/4) OF SECTION 13, TOWN 2 NORTH, RANGE 15 EAST  
CITY OF DELAVAN, WALWORTH COUNTY, WISCONSIN.

SUGGESTED FIRST FLOOR ELEVATION: 948.80  
SUGGESTED GARAGE ELEVATION: 948.47  
SUGGESTED YARD ELEVATION: 948.13



NOTE: EXPOSE SANITARY SEWER LATERAL BEFORE CONSTRUCTION TO VERIFY GRAVITY FLOW  
FROM THE BASEMENT.

REFERENCE BEARING: ALL BEARINGS ARE REFERENCED TO GRID NORTH OF THE WISCONSIN STATE PLANE COORDINATE  
SYSTEM SOUTH ZONE.

⊗ 10' OFFSET STAKES

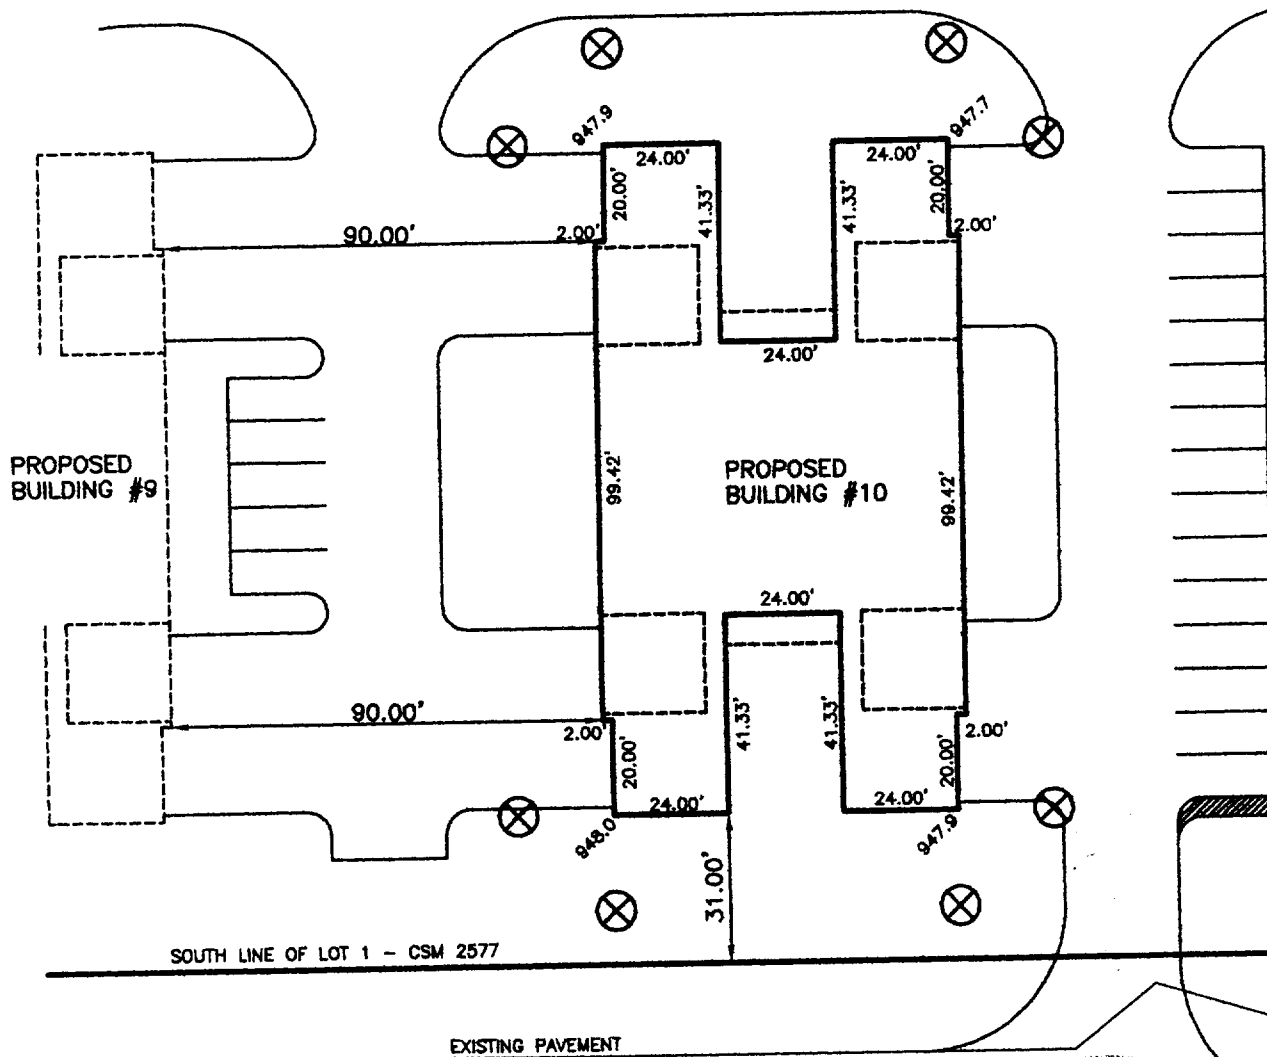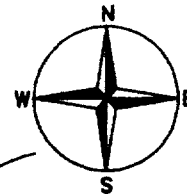

PLAN DATED: DECEMBER 8, 1998  
FILE NO.: D:\9800\98201  
PLAN SCALE: 1" = 40'

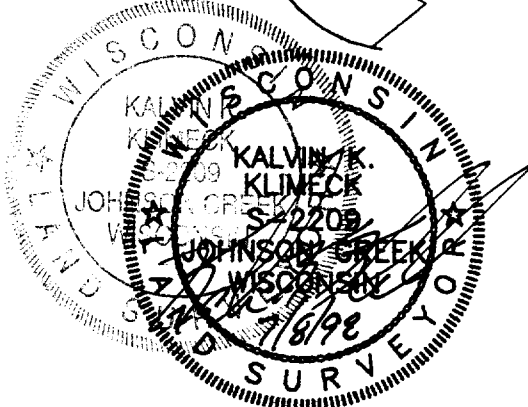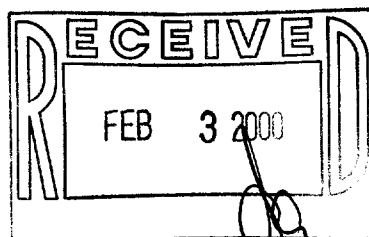

STATE OF WISCONSIN }  
COUNTY OF JEFFERSON } SS.

WE, PIONEER ENGINEERING & SURVEYING, DO HEREBY CERTIFY THAT WE HAVE MADE THIS SURVEY AND THAT  
THE INFORMATION AS SHOWN ON THE ABOVE PLAT OF SURVEY IS TRUE AND CORRECT REPRESENTATION THEREOF.

**PIONEER ENGINEERING  
AND SURVEYING**

CONSULTANTS IN SUBDIVISIONS  
AND COMMERCIAL DEVELOPMENTS

3902 C.T.H. "B"

JOHNSON CREEK, WI. 53038

(920) 699 - 3330 FAX: 699 - 3332

002-1818  
XFILE-10