


SURVEYING & ENGINEERING
DELAVER, WISCONSIN

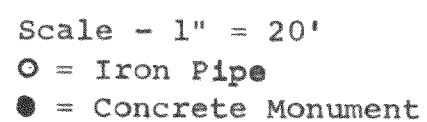

I, George T. Dunham do hereby certify that I have surveyed the property described as follows,
Lot 5, Block 1 of Sunny Side Subdivision located in the City of Delavan, Walworth County, Wisconsin,
and that the plat shown above is a correct representation of the property lines and of the improvements located thereon.
March 2, 1962

X55-5