

ABELL SURVEYING & MAPPING

1140 SEQUOIA STREET • DELAVAN, WISCONSIN 53115
262-728-6737

SOUTHWEST CORNER LOT 15,
BLOCK 14, PASSAGE, ARAM
AND DOWNIE'S ADDITION

STREET

50'

SEVENTH

S.T.H.

BLOCK

NOTE: BEARINGS ARE REFERENCED TO
EXISTING SURVEY RECORDS.

N



SCALE 1"=30'

LEGEND

- - IRON PIPE FOUND
- - CONCRETE MONUMENT FOUND
- ✕ - CUT CROSS IN CONCRETE FOUND
- - IRON PIPE SET
- () - RECORDED AS

REVISED DATE: MAY 23, 2000
REVISED TO SHOW LOCATION OF
CHAINLINK FENCE
ORDERED BY: BARKER BUILDING SUPPLY
327 S. SEVENTH STREET
DELAVAN, WI 53115

XP-176
XP-177

002-1846


LOT 24
TAX PARCEL XP-176

LOT 25
TAX PARCEL XP-177

LOT 28

PLAT OF SURVEY OF

PART OF THE NORTHWESTERLY LINE, AND THE SOUTHWESTERLY
LINE OF TAX PARCEL XP-173 AND THE WEST LINE OF TAX
PARCELS XP-176 AND XP-177, BEING PART OF LOTS 20,
24, 25 AND 28, BLOCK 13 OF PASSAGE, ARAM AND
DOWNIE'S ADDITION TO THE CITY OF DELAVAN, WALWORTH
COUNTY, WISCONSIN.

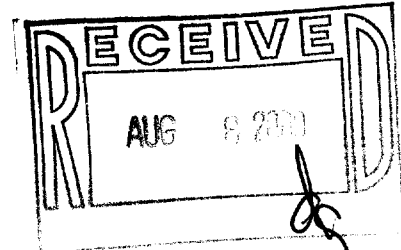

I, DAVID F. ABELL, DO HEREBY CERTIFY THAT I HAVE SURVEYED THE PROPERTY HEREON
DESCRIBED ACCORDING TO THE OFFICIAL RECORDS AND THAT THE PLAT HEREON IS A
CORRECT REPRESENTATION OF THE PROPERTY LINES TO THE BEST OF MY KNOWLEDGE AND
BELIEF.

David F. Abell

DAVID F. ABELL
WISCONSIN REGISTERED LAND SURVEYOR, S-1596

May 14, 1999

DATE: May 14, 1999 JOB NUMBER - 99076A
NOTE: THIS IS NOT A CERTIFIED COPY UNLESS SEALED.