


FARRIS, HANSEN, & ASSOCIATES, INC.
ENGINEERING, ARCHITECTURE, SURVEYING
7 RIDGWAY COURT - P.O. BOX 437, ELKHORN, WISCONSIN, 53121
PHONE: (414) 723-2098 FAX: (414) 723-5886
PLAT OF SURVEY


LOT 10 OF BLOCK 5 OF F.K. PHOENIX W ADDITION
LOCATED IN SECTION 18, TOWN 2 NORTH, RANGE 16 EAST
CITY OF DELAVAN, WALWORTH COUNTY, WISCONSIN

WORK ORDERED BY -
JOHN BOUMENOT
P.O. BOX 653
DELAVAN WI 53115

VINE STREET
82.5' WIDE

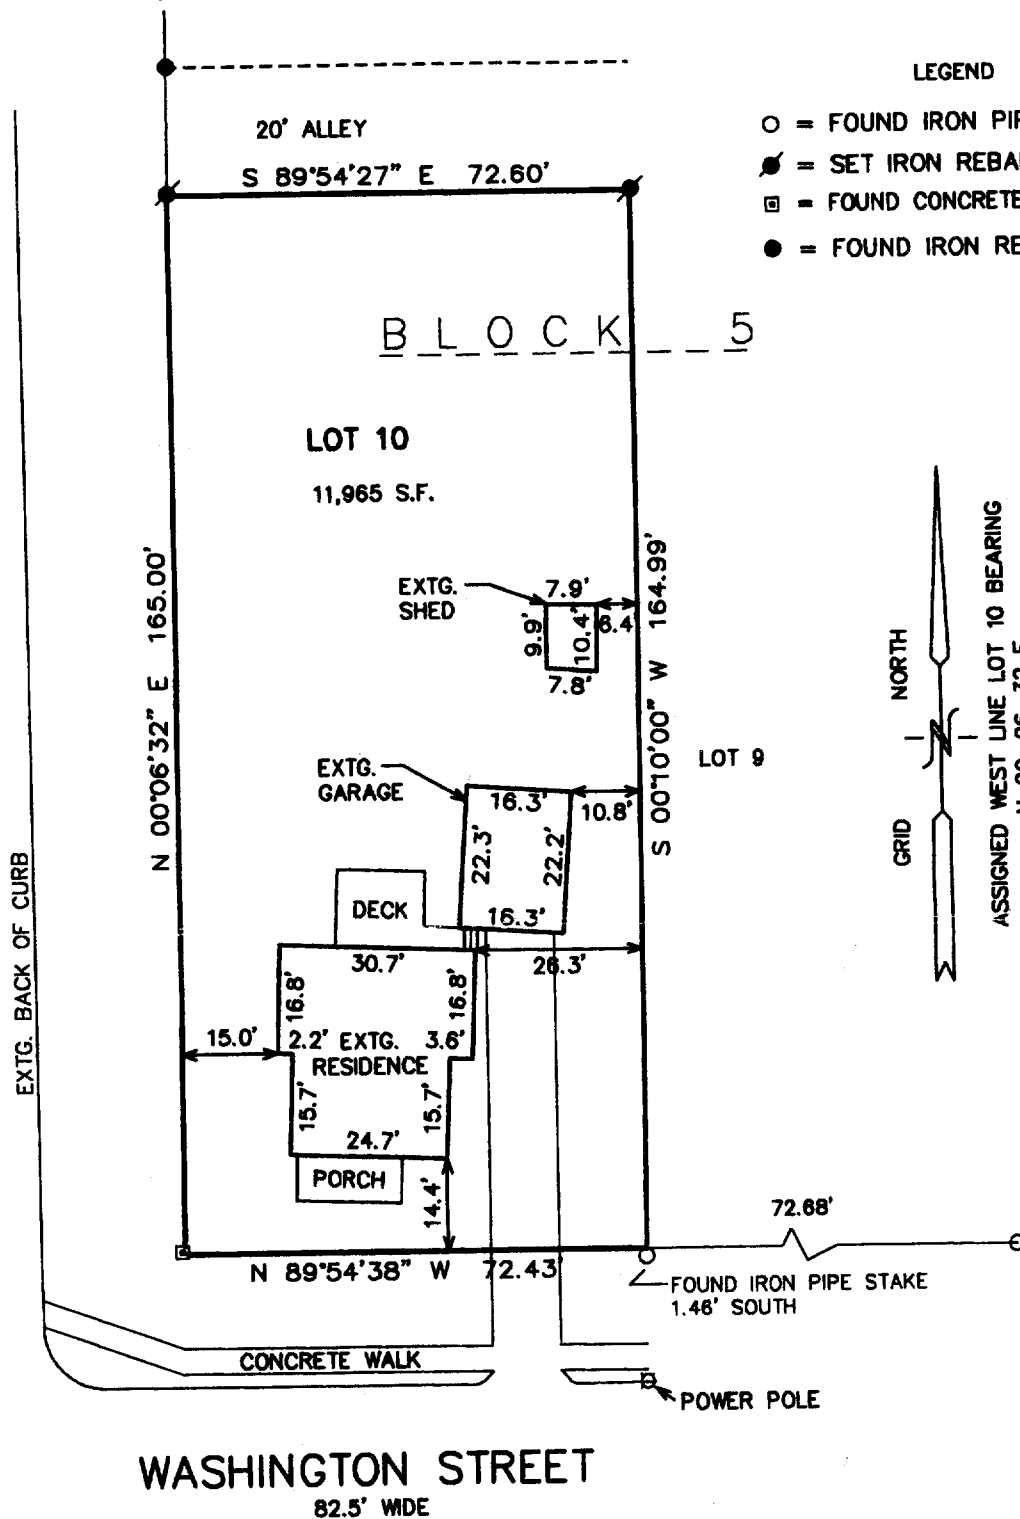

LEGEND
○ = FOUND IRON PIPE STAKE
● = SET IRON REBAR STAKE
□ = FOUND CONCRETE MONUMENT
● = FOUND IRON REBAR STAKE

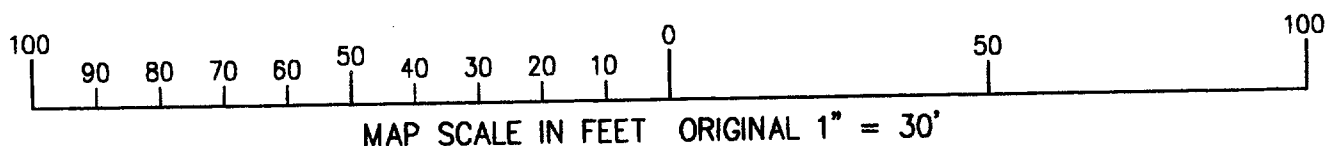


NOTE: COPIES OF THIS MAP TO WHICH THE FOLLOWING CERTIFICATE WILL APPLY SHOW SURVEYOR'S ORIGINAL SEAL AND SIGNATURE IN RED INK. COPIES BY ANY OTHER MEANS MAY HAVE ALTERATIONS WHICH DO NOT REPRESENT THE SURVEYOR'S WORK PRODUCT.

I HEREBY CERTIFY THAT THE ABOVE DESCRIBED PROPERTY HAS BEEN SURVEYED UNDER MY DIRECTION AND THAT THE ABOVE MAP IS A TRUE REPRESENTATION THEREOF AND SHOWS THE SIZE AND LOCATION OF THE PROPERTY AND ITS EXTERIOR BOUNDARIES. THIS SURVEY IS MADE FOR THE USE OF THE PRESENT OWNERS OF THE PROPERTY, AND ALSO THOSE WHO PURCHASE, MORTGAGE, OR GUARANTEE THE TITLE THERETO WITHIN ONE YEAR FROM THE DATE HEREOF.

DATED: 08-04-2000

Peter S. Gordon
PETER S. GORDON R.L.S. 2101

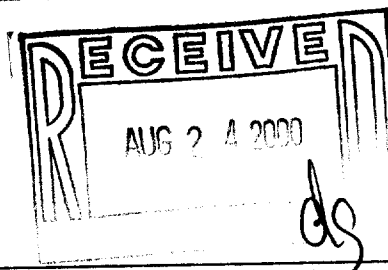

PROJECT 5648
DATE 08-02-00
SHEET 1 OF 1

AUG 04 2000

XPFR-28A
002-1861