
ABELL SURVEYING & MAPPING

1140 SEQUOIA STREET . DELAVAN, WISCONSIN 53115 262-728-6737

WASHINGTON

STREET

82.50 FEET WIDE

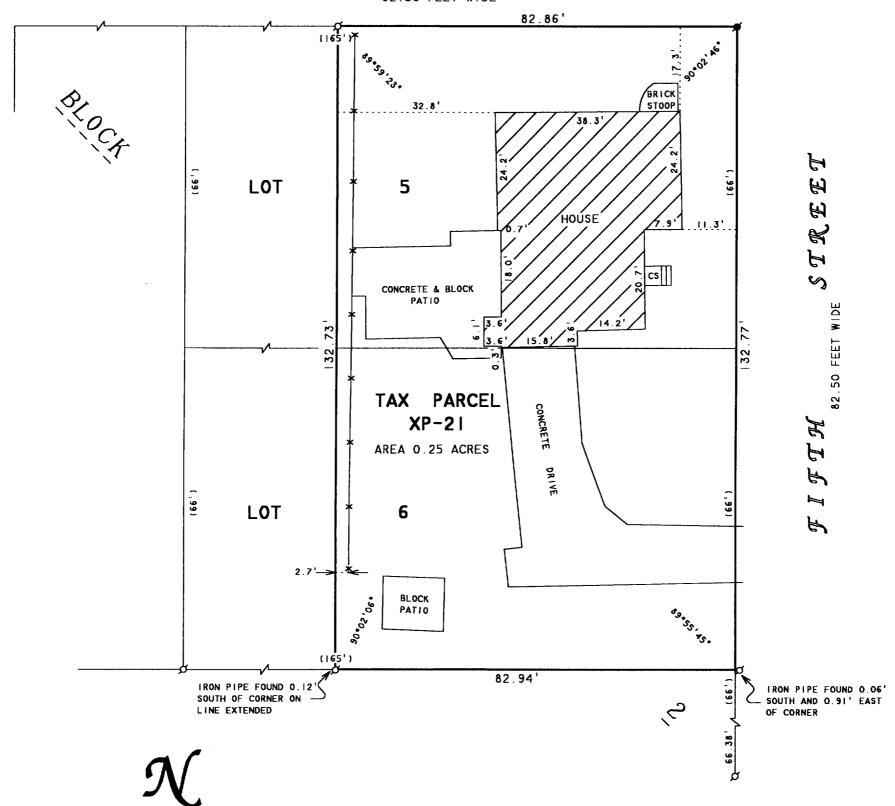



SCALE | "=20!

LEGEND

Ø -IRON PIPE FOUND **■** -CONCRETE MONUMENT FOUND CS -CONCRETE STOOP X -WOOD FENCE ()-RECORDED AS

PLAT OF SURVEY OF

THE EAST 1/2 OF LOTS 5 AND 6, BLOCK 2, PASSAGE, ARAM AND DOWNIE ADDITION TO THE

CITY OF DELAVAN, WALWORTH COUNTY F

I HEREBY CERTIFY THAT I HAVE SURVEYED THE ABOVE DESCRIBED PROPERTY AND THAT THE ABOVE MAP IS A TRUE REPRESENTATION THEREOF AND SHOWS THE SIZE AND LOCATION OF THE PROPERTY, ITS EXTERIOR BOUNDARIES. THE LOCATION OF ALL VISIBLE STRUCTURES AND DIMENSIONS OF ALL PRINCIPAL BUILDINGS THEREON, BOUNDARY FENCES, APPARENT EASEMENTS, ROADWAYS AND VISIBLE ENCROACHMENTS, IF ANY, TO THE BEST OF MY KNOWLEDGE AND BELIEF

THIS SURVEY IS MADE FOR THE USE OF THE PRESENT OWNERS OF THE PROPERTY, AND ALSO THOSE WHO PURCHASE, MORTGAGE, OR GUARANTEE THE TITLE THERETO WITHIN ONE (I) YEAR FROM DATE HEREON.

ORDERED BY: KEEFE REAL ESTATE 1155 E. GENEVA STREET DELAVAN. WI 53115

DAVID F. ABELL WISCONSIN REGISTERED LAND SURVEYOR, S-1596

August 10, 2000

JOB NUMBER - 00127 NOTE: THIS IS NOT A CERTIFIED COPY UNLESS SEALED.