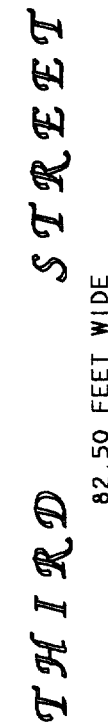


1140 SEQUOIA STREET • DELAVAN, WISCONSIN 53115
262-728-6737

 $\mathcal{N}$ 

SCALE 1" = 20'

LEGEND

- ♂ -IRON PIPE FOUND
 ■ -CONCRETE MONUMENT FOUND
 ■ -PK NAIL FOUND
 ✕ -CROSS CUT IN CONCRETE SIDEWALK
 ✕ -WOOD FENCE
 _____ -OVERHEAD UTILITY LINES
 () -RECORDED AS

PLAT OF SURVEY OF

THE EAST 110 FEET OF THE SOUTH 5 1/2 FEET OF
LOT 9, BLOCK 17 AND THE EAST 110 FEET OF LOT 10,
BLOCK 17 OF THE ORIGINAL PLAT OF THE CITY OF
DELAYAN, WALWORTH COUNTY, WISCONSIN.

I HEREBY CERTIFY THAT I HAVE SURVEYED THE ABOVE DESCRIBED PROPERTY AND THAT THE ABOVE MAP IS A TRUE REPRESENTATION THEREOF AND SHOWS THE SIZE AND LOCATION OF THE PROPERTY, ITS EXTERIOR BOUNDARIES, THE LOCATION OF ALL VISIBLE STRUCTURES AND DIMENSIONS OF ALL PRINCIPAL BUILDINGS THEREON, BOUNDARY FENCES, APPARENT EASEMENTS, ROADWAYS AND VISIBLE ENCROACHMENTS, IF ANY, TO THE BEST OF MY KNOWLEDGE AND BELIEF.

THIS SURVEY IS MADE FOR THE USE OF THE PRESENT OWNERS OF THE PROPERTY, AND ALSO THOSE WHO PURCHASE, MORTGAGE, OR GUARANTEE THE TITLE THERETO WITHIN ONE (1) YEAR FROM DATE HEREON.

DAVID F. ABELL
WISCONSIN REGISTERED LAND SURVEYOR, S-1596

August 7, 2000

DATE _____ JOB NUMBER - 00120
NOTE: THIS IS NOT A CERTIFIED COPY UNLESS SEALED.

NOTE: DIMENSIONS USED FOR BLOCK 17 WERE
TAKEN FROM CITY ENGINEERS RECORDS
ON FILE AT CITY HALL (DELAN, WI.)

ORDERED BY: CENTURY 21-SKANDIA REALTY
822 E. GENEVA STREET
DELAVER, WI 53115

RECEIVED
JUN 13 2000
[Signature]

NOTE: DIMENSIONS USED FOR BLOCK 17 WERE
TAKEN FROM CITY ENGINEERS RECORDS
ON FILE AT CITY HALL (DELAN, WI.)

ORDERED BY: CENTURY 21-SKANDIA REALTY
822 E. GENEVA STREET
DELAVER, WI 53115

August 7, 2000

DATE _____ JOB NUMBER - 00120
NOTE: THIS IS NOT A CERTIFIED COPY UNLESS SEALED.

XOP-188

002-1866