
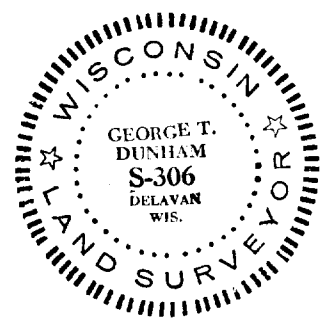


①

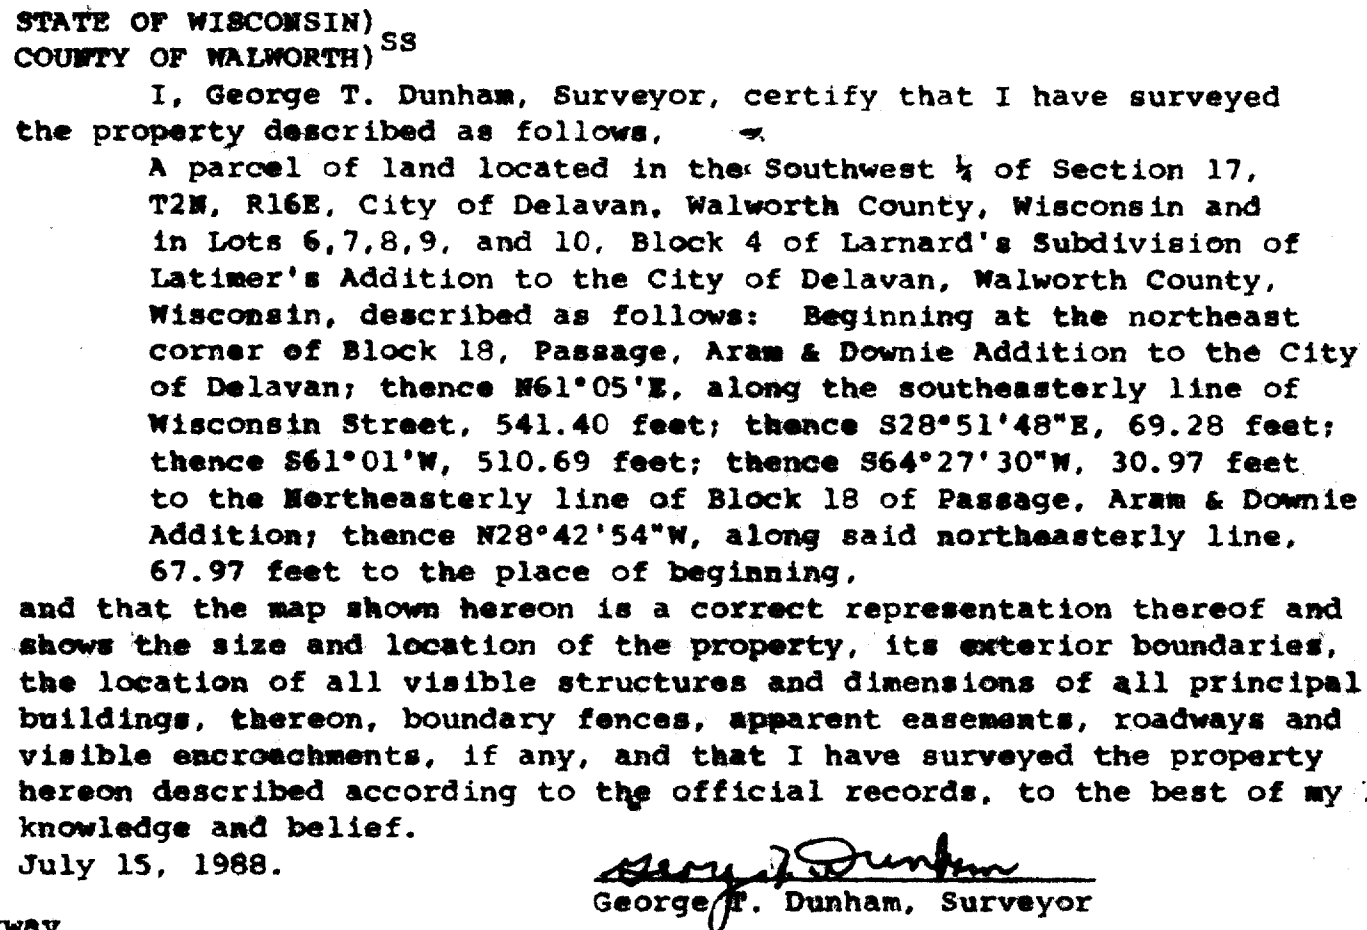

RECEIVED
MAR 26 2001