




WALWORTH COUNTY SURVEYING & MAPPING

P. O. BOX 1115
LAKE GENEVA, WISCONSIN
414-248-0505


PLAT OF SURVEY OF

LOT 6, BLOCK 5 OF CONVERSE SUBDIVISION IN THE CITY OF DELAVAN, TOGETHER WITH THE FOLLOWING PARCEL: BEGINNING AT THE SOUTHWEST CORNER OF LOT 6 IN BLOCK 5 OF CONVERSE SUBDIVISION, THENCE SOUTHWESTERLY ALONG THE NORTHWESTERLY LINE OF WISCONSIN STREET 22 FEET; THENCE NORTHWESTERLY PARALLEL TO THE SOUTHWESTERLY LINE OF SAID LOT 6, 165 FEET; THENCE NORTHEASTERLY PARALLEL TO THE NORTHWESTERLY LINE OF WISCONSIN STREET 22 FEET; THENCE SOUTHEASTERLY, ALONG THE SOUTHWESTERLY LINE OF SAID LOT 6 TO THE PLACE OF BEGINNING.

ORDERED BY: WASSEL, KILKENNY & DANZ
P. O. BOX 447
DELAVAN, WISCONSIN
53115

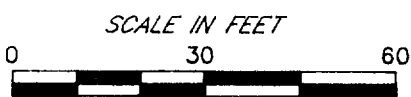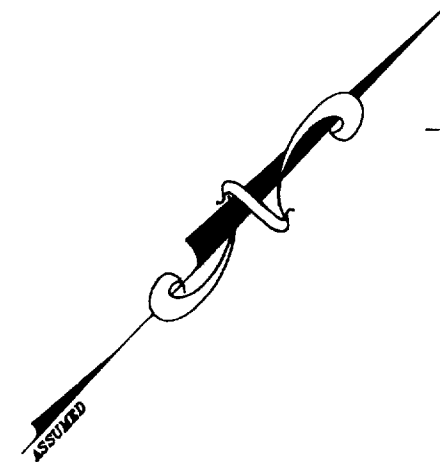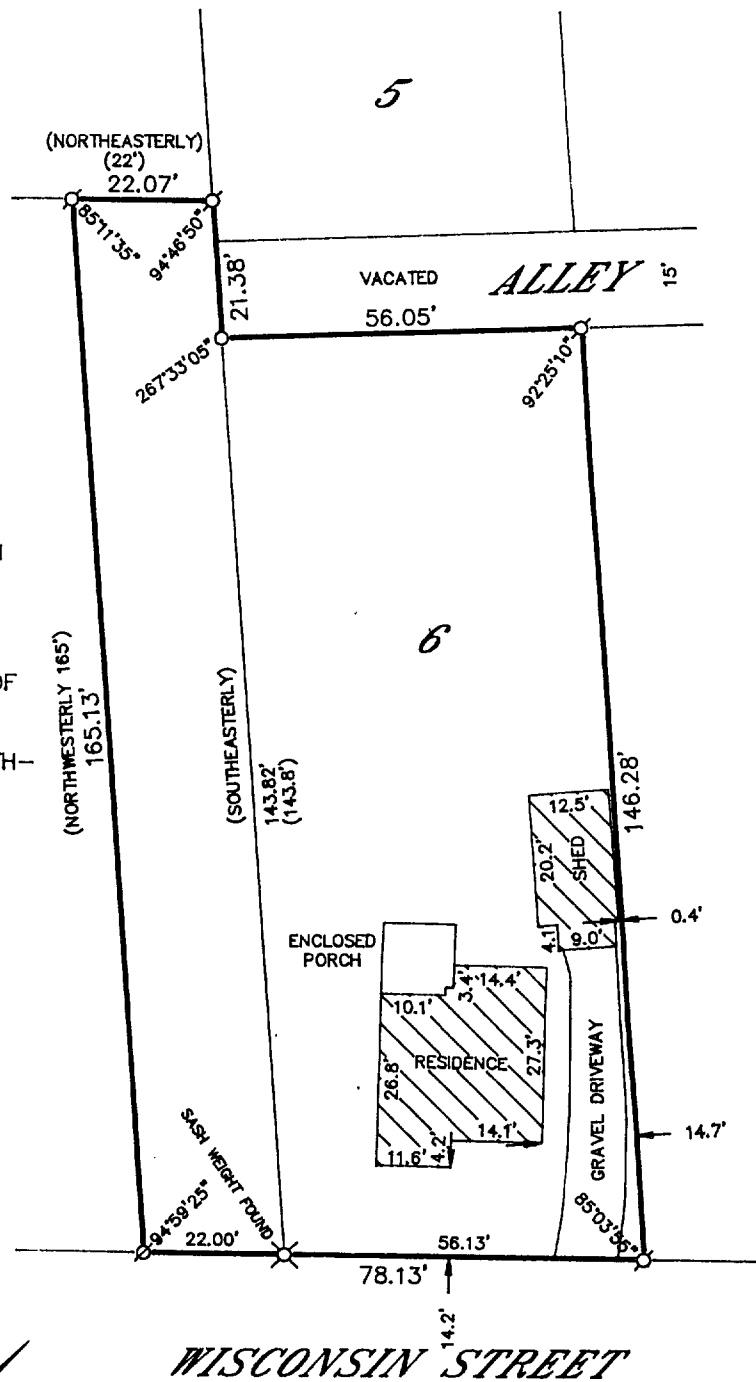

LEGEND
 ○-IRON PIPE FOUND
 ⊗-IRON ROD FOUND
 ●-CONCRETE MONUMENT FOUND
 ○-IRON PIPE PLACED
 ()-RECORDED AS

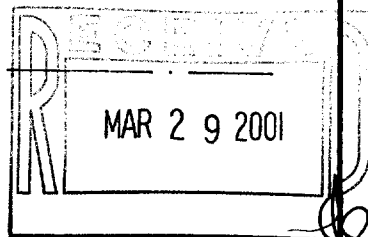

I HEREBY CERTIFY THAT I HAVE SURVEYED THE ABOVE DESCRIBED PROPERTY AND THAT THE ABOVE MAP IS A TRUE REPRESENTATION THEREOF AND SHOWS THE SIZE AND LOCATION OF THE PROPERTY, ITS EXTERIOR BOUNDARIES, THE LOCATION OF ALL VISIBLE STRUCTURES AND DIMENSIONS OF ALL PRINCIPAL BUILDINGS THEREON, BOUNDARY FENCES, APPARENT EASEMENTS, ROADWAYS AND VISIBLE ENCROACHMENTS, IF ANY, TO THE BEST OF MY KNOWLEDGE AND BELIEF.

THIS SURVEY IS MADE FOR THE USE OF THE PRESENT OWNERS OF THE PROPERTY AND ALSO THOSE WHO PURCHASE, MORTGAGE OR GUARANTEE THE TITLE THERETO WITHIN ONE (1) YEAR FROM DATE HEREOF.

Robert M. Baerenwald
 ROBERT M. BAERENWALD
 WISCONSIN REGISTERED LAND SURVEYOR, S-1508

DATE *Sept. 16, 1997* JOB NO. 5606

NOTE: THIS IS NOT A CERTIFIED COPY UNLESS SEALED.

XCS-43
 002-1902