

PLAT OF SURVEY
LOT 39 BLOCK 11
LAKE MEADOWS ADDITION NO. 4

WORK ORDERED BY -
WILLIAM BOHN
2903 BORG ROAD
DELEVAN, WISCONSIN 53115




FARRIS, HANSEN & ASSOCIATES, INC.
Engineering, Architecture, Surveying
7 Ridgway Court P.O. Box 437
ELKHORN, WISCONSIN 53121
Office: (262) 723-2098
Fax: (262) 723-5886

REVISIONS

PROJECT NO.
3686.39.11
DATE:
07-26-01
SHEET NO.
1 OF 1

PLAT OF SURVEY

LOT 39 OF BLOCK 11 OF LAKE MEADOWS
ADDITION NO. 4, LOCATED IN THE SW
1/4 OF THE SE 1/4 OF SECTION 7,
TOWN 2 NORTH, RANGE 16 EAST, CITY
OF DELEVAN, WALWORTH COUNTY, WISCONSIN

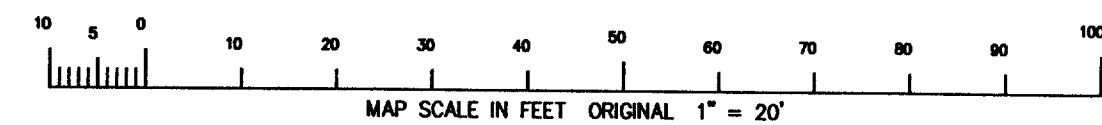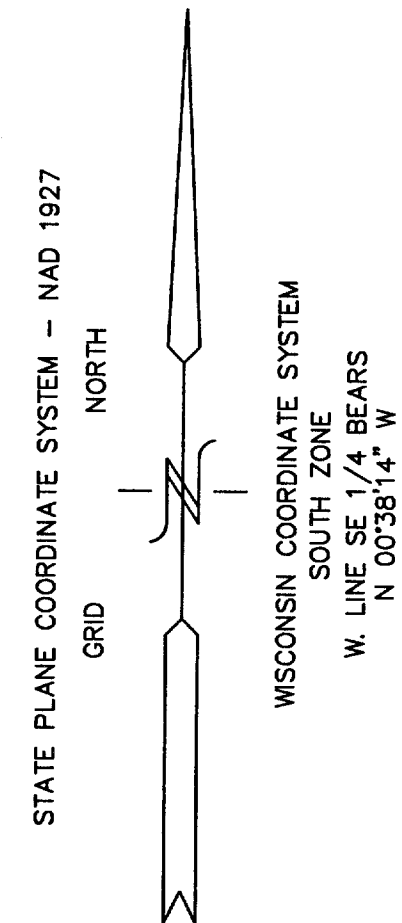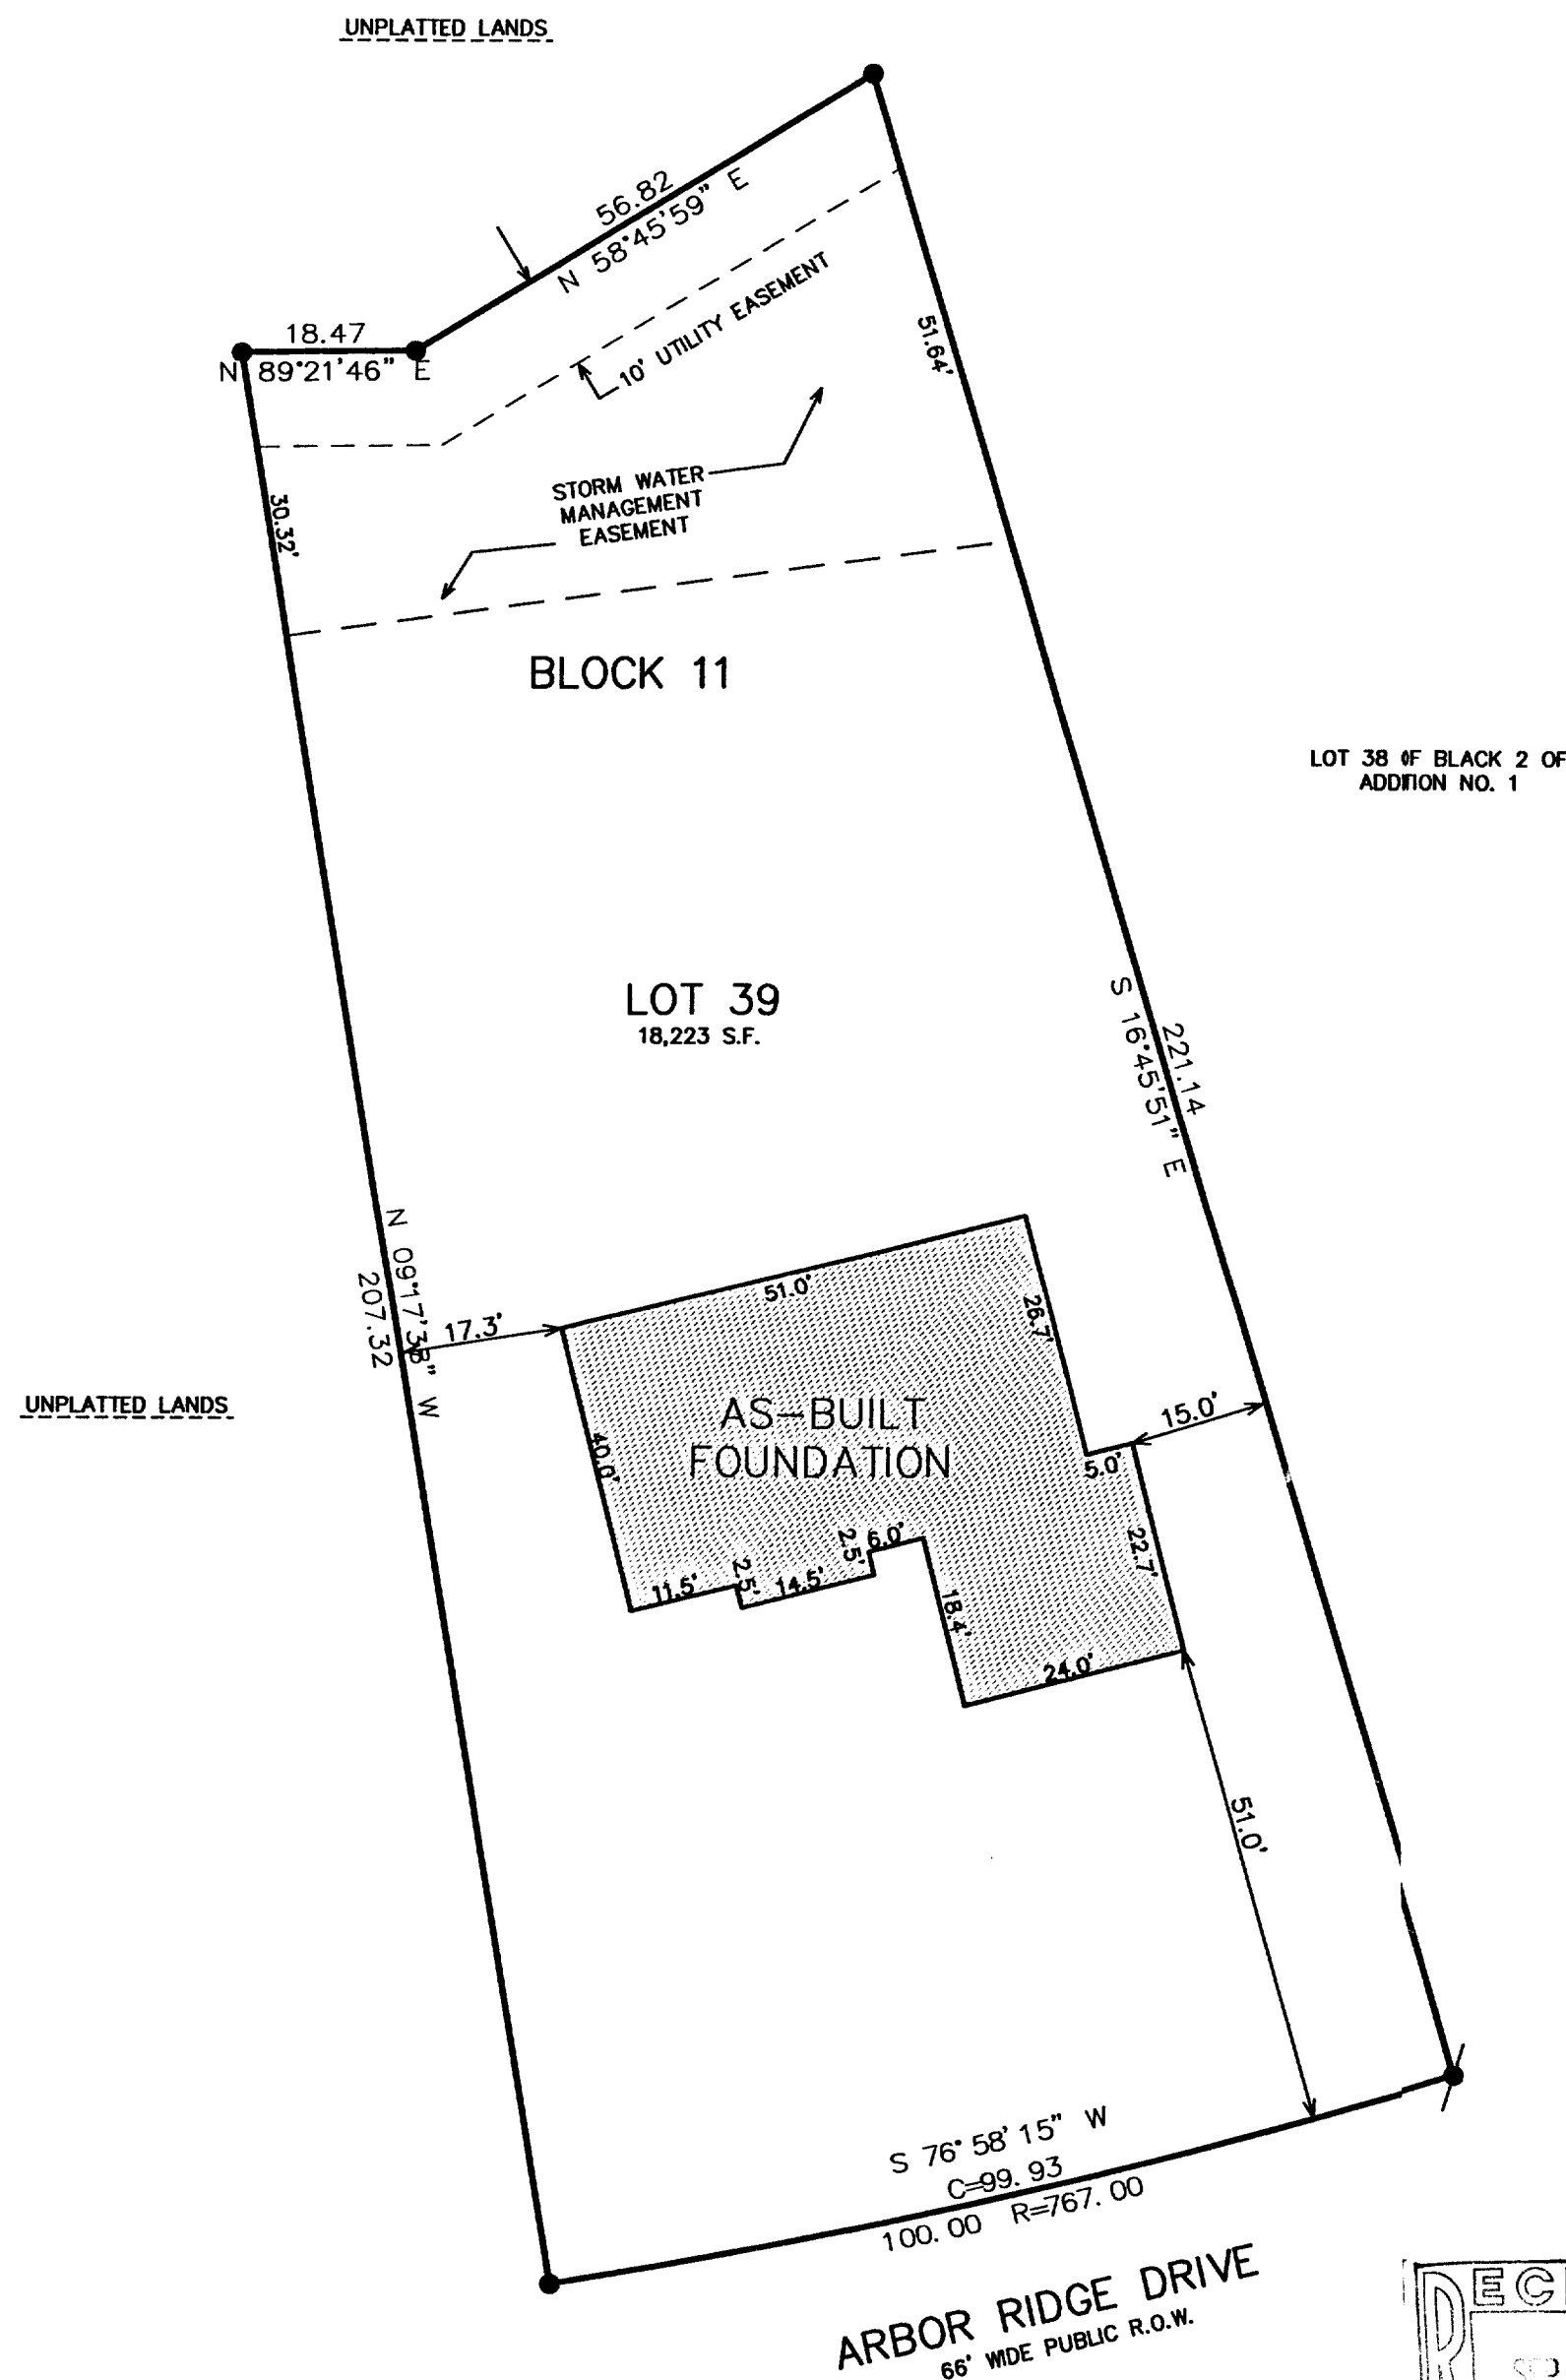

- = FOUND IRON PIPE STAKE 1" DIA.
- ⦿ = SET SOLID ROUND IRON BAR STAKE 3/4"
- = FOUND CONCRETE COUNTY MONUMENT
- ⦿ = SET SOLID ROUND IRON BAR STAKE 1 5/16"
- (XXX) = RECORDED AS


NOTE: COPIES OF THIS MAP TO WHICH THE FOLLOWING
CERTIFICATE WILL APPLY SHOW SURVEYOR'S ORIGINAL
SEAL AND SIGNATURE IN RED INK. COPIES BY
ANY OTHER MEANS MAY HAVE ALTERATIONS WHICH DO NOT
REPRESENT THE SURVEYOR'S WORK PRODUCT.

I HEREBY CERTIFY THAT THE ABOVE DESCRIBED PROPERTY
HAS BEEN SURVEYED UNDER MY DIRECTION AND THAT THE
ABOVE MAP IS A TRUE REPRESENTATION
THEREOF AND SHOWS THE SIZE AND LOCATION OF THE
PROPERTY AND ITS EXTERIOR BOUNDARIES. THIS SURVEY
IS MADE FOR THE USE OF THE PRESENT OWNERS
OF THE PROPERTY, AND ALSO THOSE WHO PURCHASE,
MORTGAGE, OR GUARANTEE THE TITLE THERETO WITHIN
ONE YEAR FROM THE DATE HEREOF.

DATED: 7-26-01

PETER S. GORDON R.L.S. 2101

Revised 8/6/2001
to correct scrivener's error

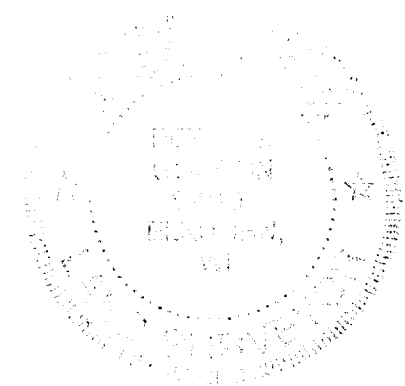

Xcm4-1 2-1933