
PLAT OF SURVEY

LOT 20 OF BLOCK 9 &

4 FEET OFF THE ENTIRE WEST SIDE OF LOT 19
BLOCK 9 OF THE ORIGINAL PLAT OF THE
CITY OF DELAVAN
WALWORTH COUNTY WISCONSIN



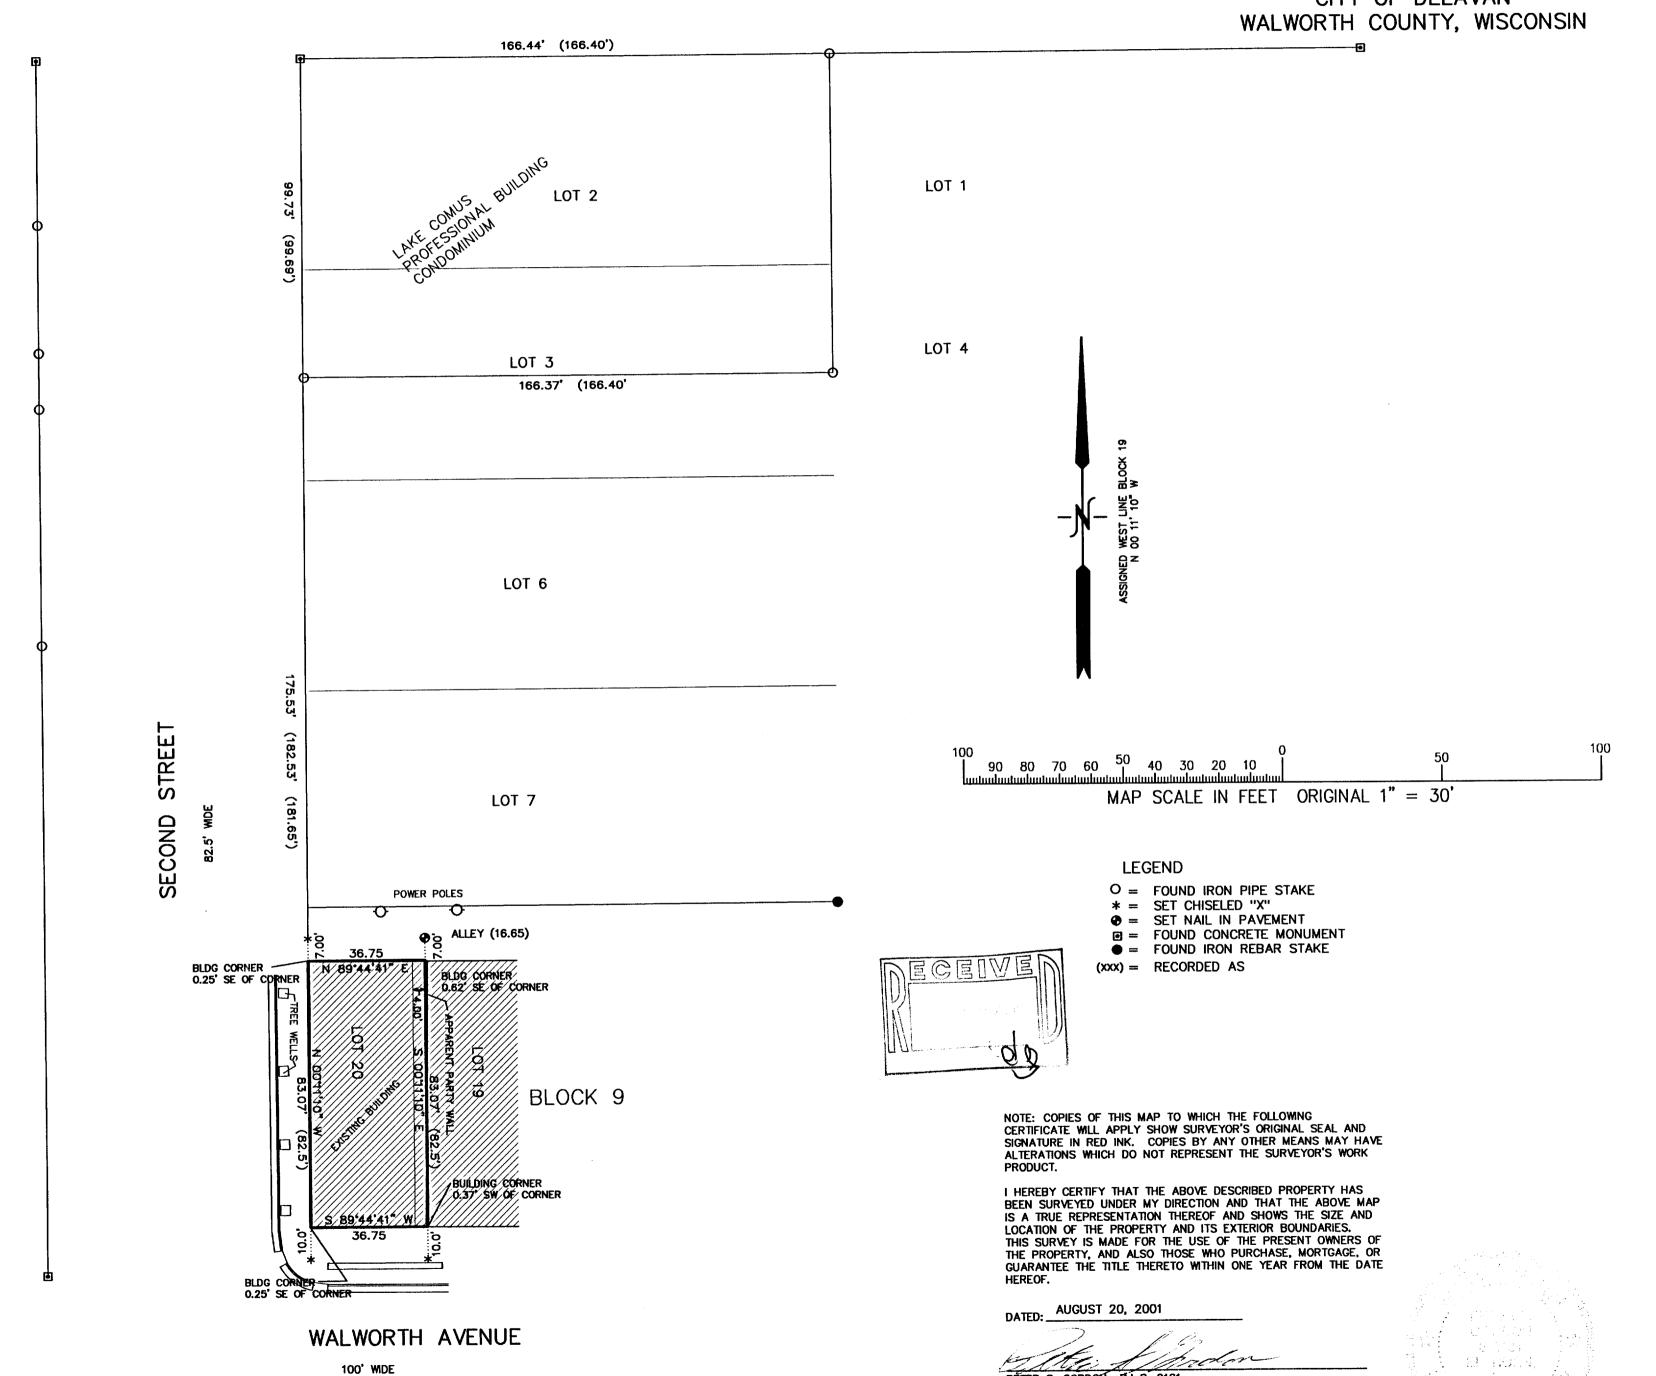

PÉTER S. GORDON R.L.S. 2101

ALIC 9.9 2001

02-1934

10P-72

REVISIONS

PROJECT NO. 5865 DATE: 08-20-2001

08-20-200 SHEET NO. 1 OF 1