

PLAT OF SURVEY

LOT 39 OF BLOCK 12 OF LAKE MEADOWS
ADDITION NO. 4, LOCATED IN THE SW
1/4 OF THE SE 1/4 OF SECTION 7,
TOWN 2 NORTH, RANGE 16 EAST, CITY
OF DELEVAN, WALWORTH COUNTY, WISCONSIN




PLAT OF SURVEY
LOT 39 BLOCK 12
LAKE MEADOWS ADDITION NO. 4

WORK ORDERED BY --
WILLIAM BOHN
2903 BORG ROAD
DELEVAN, WISCONSIN 53115

FARRIS, HANSEN & ASSOCIATES, INC.
Engineering, Architecture, Surveying
7 Ridgway Court P.O. Box 437
ELKHORN, WISCONSIN 53121
Office: (262) 723-2098
Fax: (262) 723-5666

REVISIONS


PROJECT NO.
3686.39.12
DATE:
07-26-01
SHEET NO.
1 OF 1

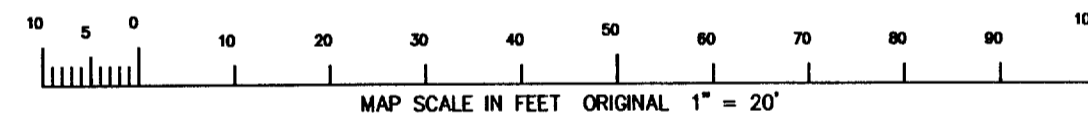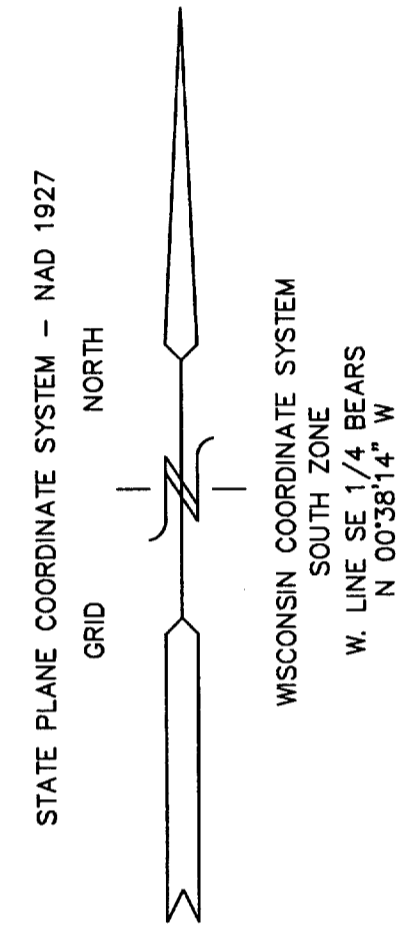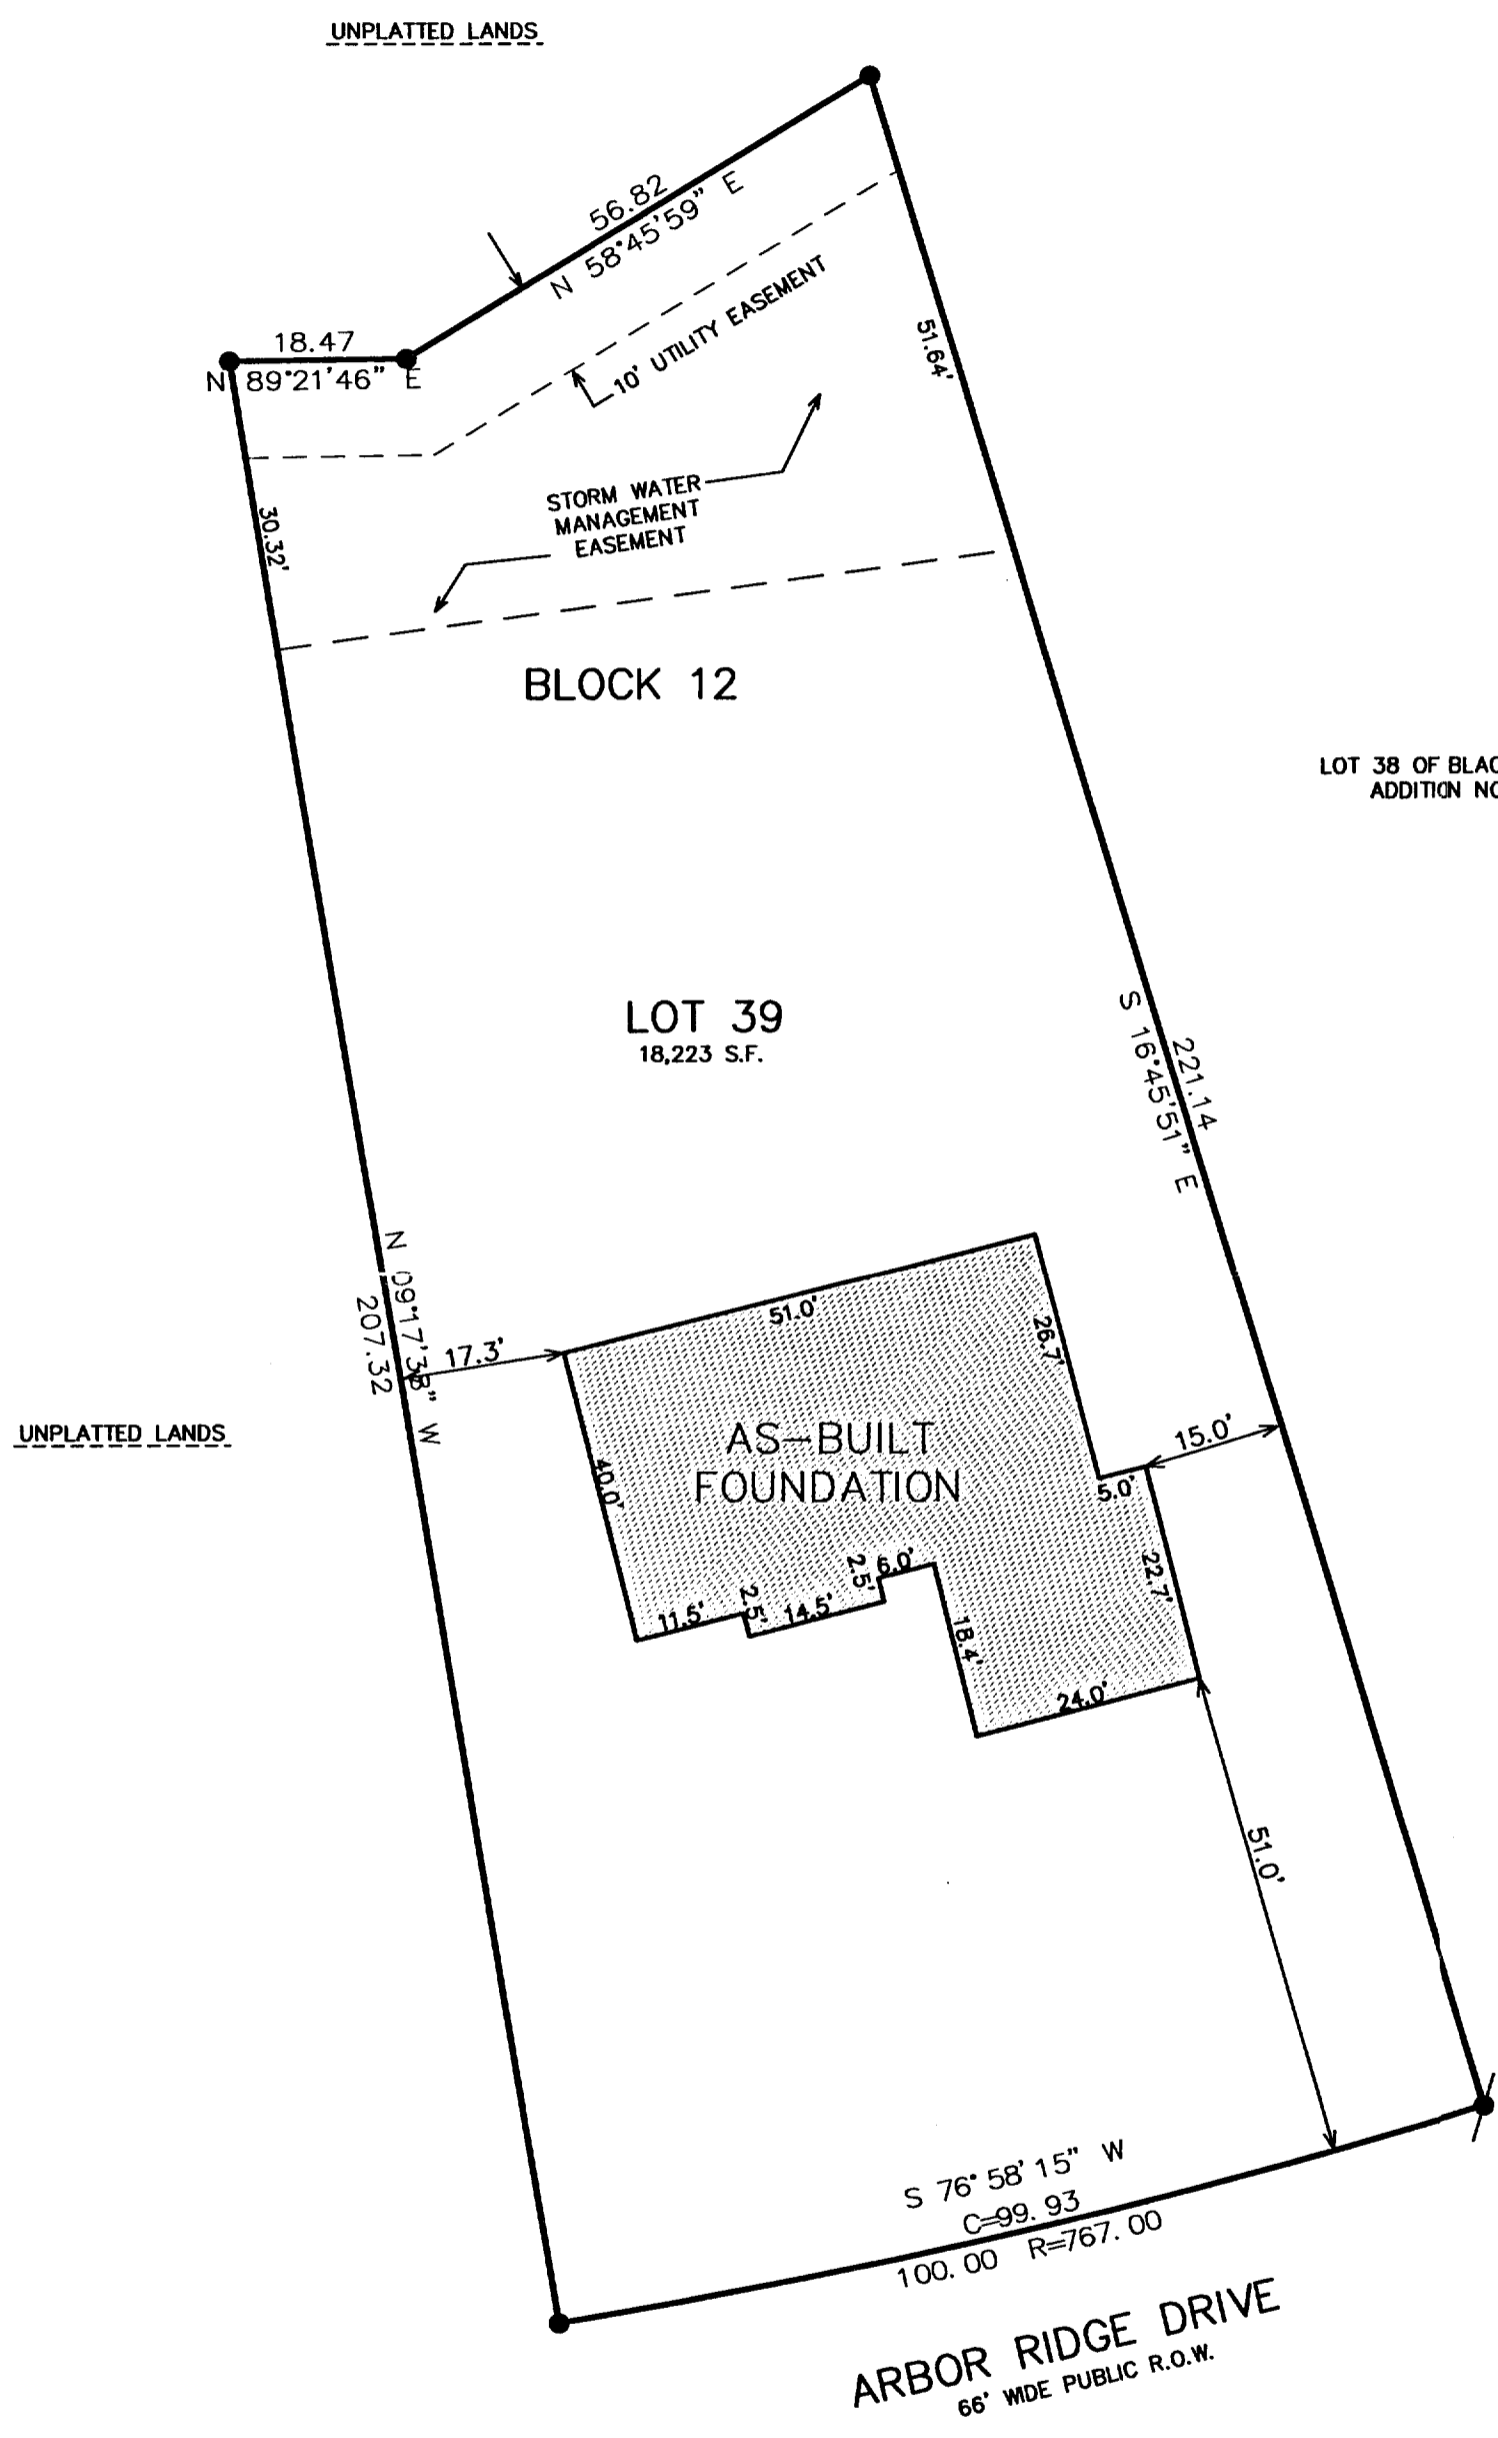

- = FOUND IRON PIPE STAKE 1" DIA.
- ⊙ = SET SOLID ROUND IRON BAR STAKE 3/4"
- ⊠ = FOUND CONCRETE COUNTY MONUMENT
- ⊙ = SET SOLID ROUND IRON BAR STAKE 1 5/16"
- (XXX) = RECORDED AS


NOTE: COPIES OF THIS MAP TO WHICH THE FOLLOWING CERTIFICATE WILL APPLY SHOW SURVEYOR'S ORIGINAL SEAL AND SIGNATURE IN RED INK. COPIES BY ANY OTHER MEANS MAY HAVE ALTERATIONS WHICH DO NOT REPRESENT THE SURVEYOR'S WORK PRODUCT.

I HEREBY CERTIFY THAT THE ABOVE DESCRIBED PROPERTY HAS BEEN SURVEYED UNDER MY DIRECTION AND THAT THE ABOVE MAP IS A TRUE REPRESENTATION THEREOF AND SHOWS THE SIZE AND LOCATION OF THE PROPERTY AND ITS EXTERIOR BOUNDARIES. THIS SURVEY IS MADE FOR THE USE OF THE PRESENT OWNERS OF THE PROPERTY, AND ALSO THOSE WHO PURCHASE, MORTGAGE, OR GUARANTEE THE TITLE THERETO WITHIN ONE YEAR FROM THE DATE HEREOF.

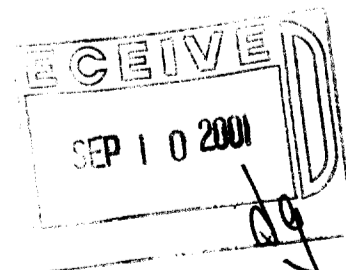

DATED: 07/26/01

Peter S. Gordon
PETER S. GORDON R.L.S. 2101

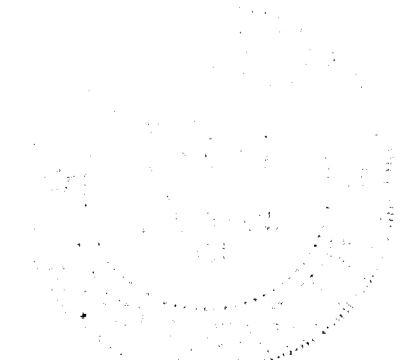

JUL 26 2001
XLM4-1
002-1936