
GEORGE T. DUNHAM SURVEYING & SUBDIVIDING DELAVAN, WISCONSIN

WALWORTH

AVENUE

(100')

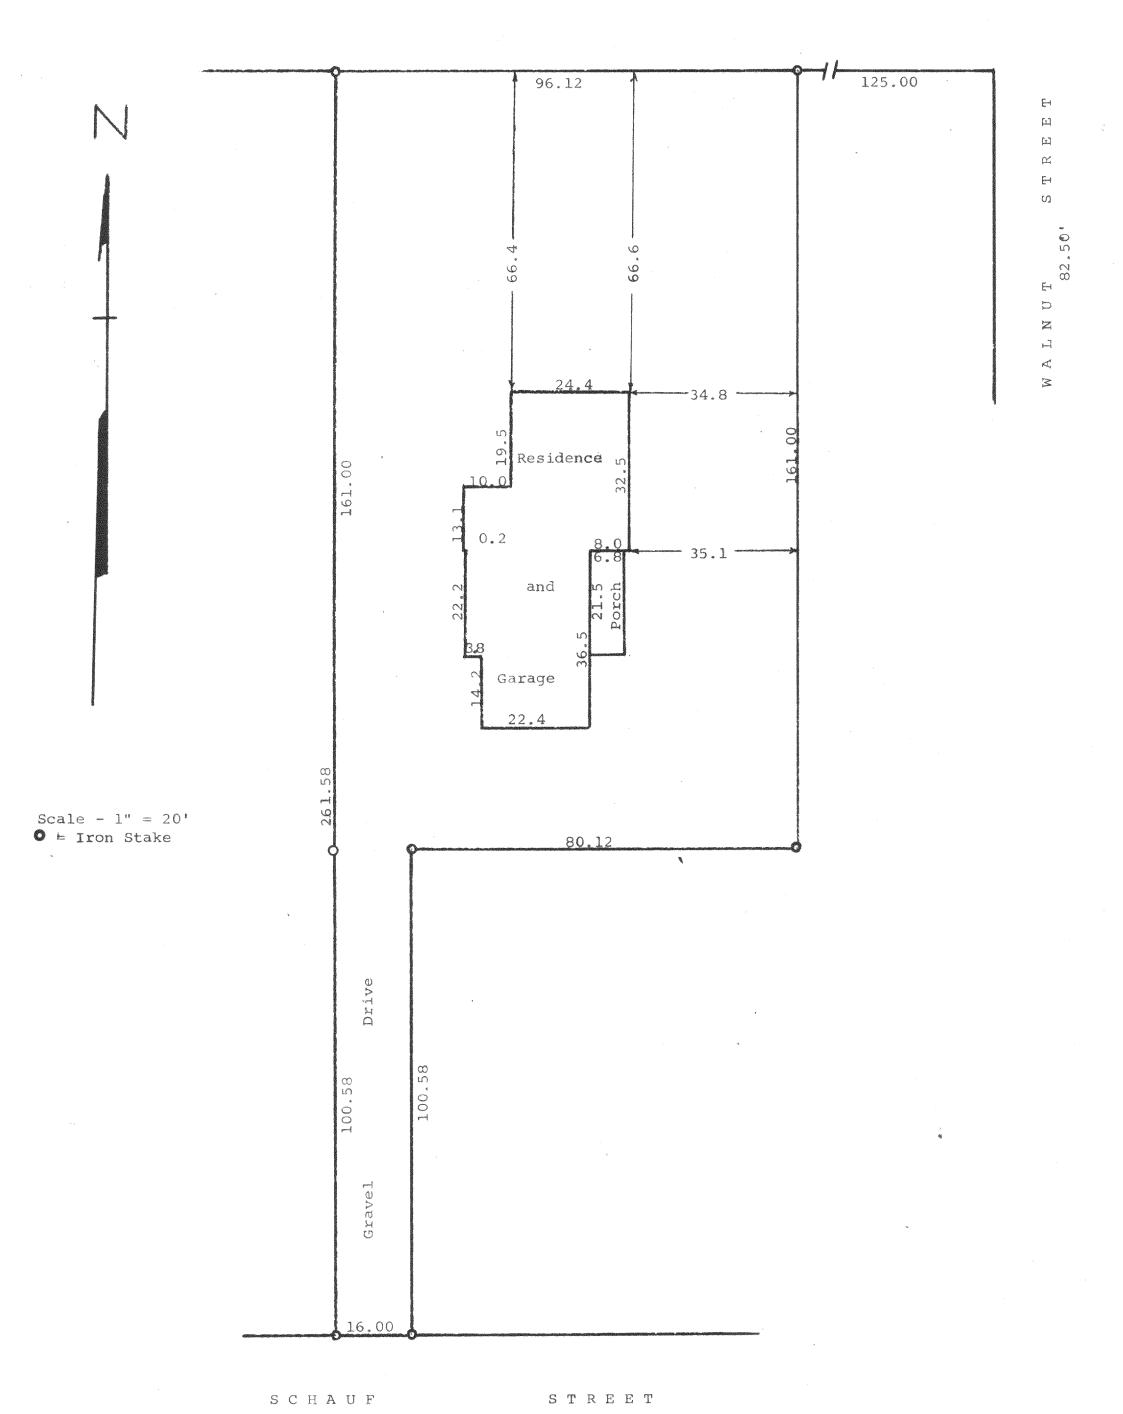

STATE OF WISCONSIN) SS

WALWORTH COUNTY I, George T. Dunham, Surveyor, do hereby certify that I

have surveyed the property described as follows,

A parcel of land located in the Southwest & of Section 18, T 2 N R 16 E, City of Delavan, Walworth County, Wisconsin, described as follows, to-wit: Commencing at the intersection of the south line of Walworth Avenue and the west line of Walnut Street in said City of Delavan; thence west along the south line of Walworth Avenue 125.00 feet to a gas pipe, which is theplace of beginning; thence continue west on the south line of said Walworth Avenue a distance of 96.12 feet to a gas pipe; thence south in a line parallel with the west line of Walnut Street a distance of 161 feet to a gas pipe; thence continue south on said line a distance of 100.58 feet to a gas pipe; thence easterly in a line parallel with the south line of Walworth Avenue a distance of 16 feet; thence north in a line parallel with the west line of Walnut Street a distance of 100.58 feet; thence easterly in a line parallel with the south line of Walworth Avenue a distance of 80.12 feet to a gas pipe; thence north in a line parallel with the west line of Walnut Street 161.feet to the place of beginning.

and that the above plat is an accurate survey and a true representation thereof and correctly shows the location of buildings on said property and the correct measurements thereof.

August 12, 1964 Revised November 11, 1964

K & E 10-5155-250-8-64