




DUNHAM SURVEYING, S.C.  
SURVEYING & SUBDIVIDING  
DELAVAN, WISCONSIN 53115

Scale - 1" = 10'  
O = Iron Pipe  
X = Cross in Concrete Found  
--- = Fence Line  
Survey ordered by:  
Judy Gamble  
719 Burr Oak Court  
Delavan, WI 53115

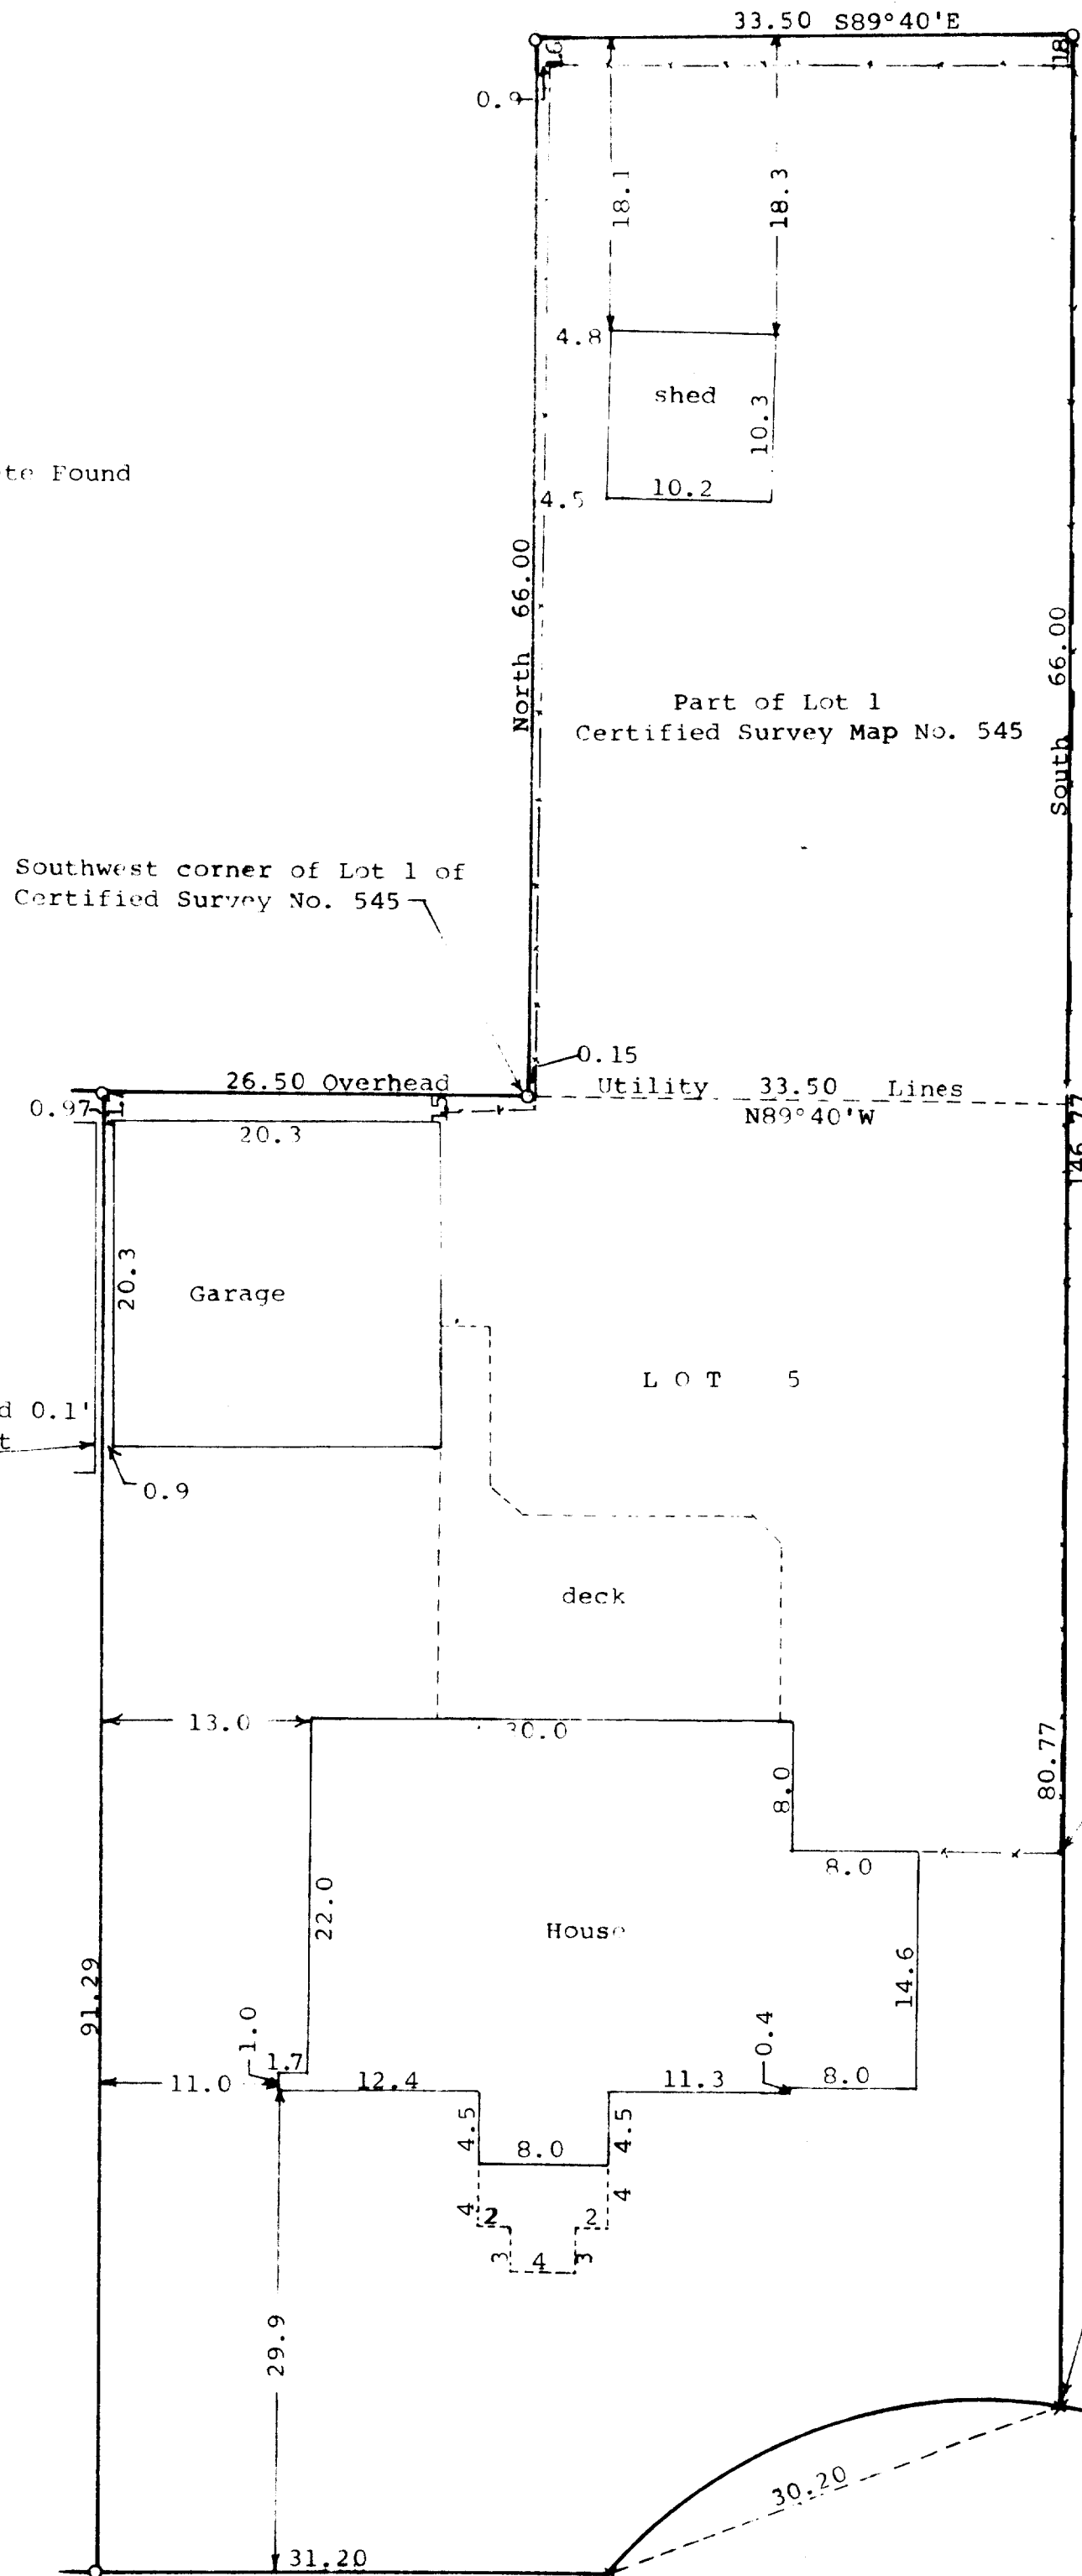

STATE OF WISCONSIN) SS  
COUNTY OF WALWORTH)

I, George T. Dunham, Surveyor, certify that I have surveyed the property described as follows:

Lot 5 of Burr Oak Subdivision, located in the City of Delavan, Walworth County, Wisconsin.  
TOGETHER with: A parcel of land located in Lot 1 of Certified Survey No. 545, recorded in Volume 2 of Certified Surveys on Pages 390 and 391 in the Office of the Register of Deeds, Walworth County, Wisconsin, described as follows: Beginning at the southwest corner of said Lot 1; thence North 66.00 feet to the Northwest corner of said Lot 1; thence S89°40'E along the north line of said Lot 1, 33.50 feet; thence South 66.00 feet to the south line of said Lot 1; thence N89°40'W 33.50 feet to the place of beginning, (Description of the west end of Lot 1, Certified Survey No. 545, deeded to the owner of Lot 5, Burr Oak Subdivision, City of Delavan, Walworth County, Wisconsin.



and that the plat shown hereon is a correct representation thereof and shows the size, location of the property, its exterior boundaries, the location of all visible structures and dimensions of all principal buildings thereon, boundary fences, apparent easements, roadways and visible encroachments, if any, and that I have surveyed the property hereon described, according to the official records, to the best of my knowledge and belief.

December 8, 1976

Updated and recertified to this  
6th day of August, 1992

Updated and recertified to this  
23rd day of July, 1998

*George T. Dunham*  
George T. Dunham, Surveyor

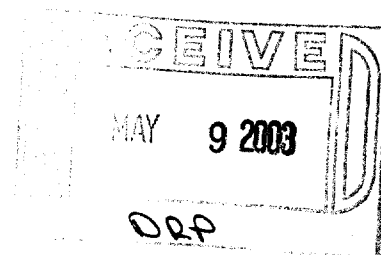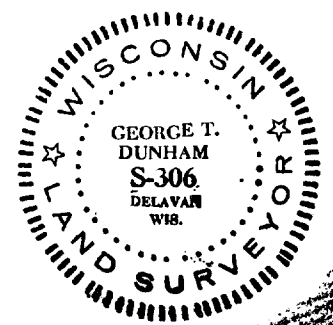

BURR OAK COURT