
DUNHAM SURVEYING, S.C. SURVEYING & SUBDIVIDING DELAVAN, WISCONSIN 53115

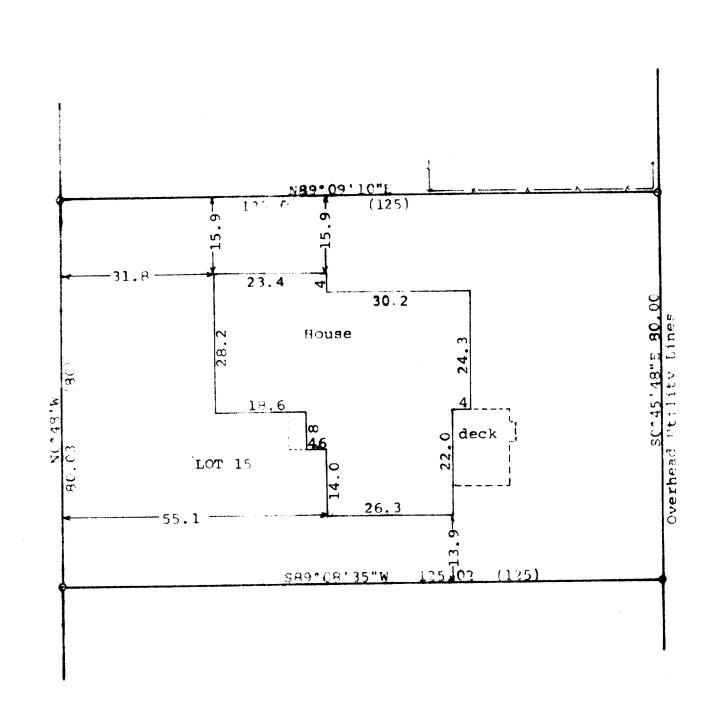

Scale - 1' * 20'

o = 1" Iron Pipe Found

● = 3/4" Iron Rod Found

- Fence Line

((.00' = recorded distance

Bearings are referenced to the east line of Tyrrell Avenue with the recorded bearing of NO°48'W

Updating and recertification ordered by: Montsma Builders

917 Racine Street

Delavan, WI 53115

STATE OF WISCONSIN) SS

COUNTY OF WALWORTH)

I, George T. Dunham, Surveyor, certify that I have surveyed the property

described as follows:

Lot 15 in Block 3 of Allynhurst Subdivision located in the City of

Delavan, Walworth County, Wisconsin

and that the plat shown hereon is a correct representation thereof and shows the size and location of the property, its exterior boundaries, the location of all visible structures and dimensions of all principal buildings thereon, boundary fences, apparent easements, roadways and visible encroachments, if any, and that I have surveyed the property hereon described, according to the official records, to the best of my knowledge and belief.

July 9, 1996 Updated and recertified to this 29th day of March, 2000 George T. Dunham, Surveyor



