
DUNHAM SURVEYING, S.C. SURVEYING & SUBDIVIDING DELAVAN, WISCONSIN 53115

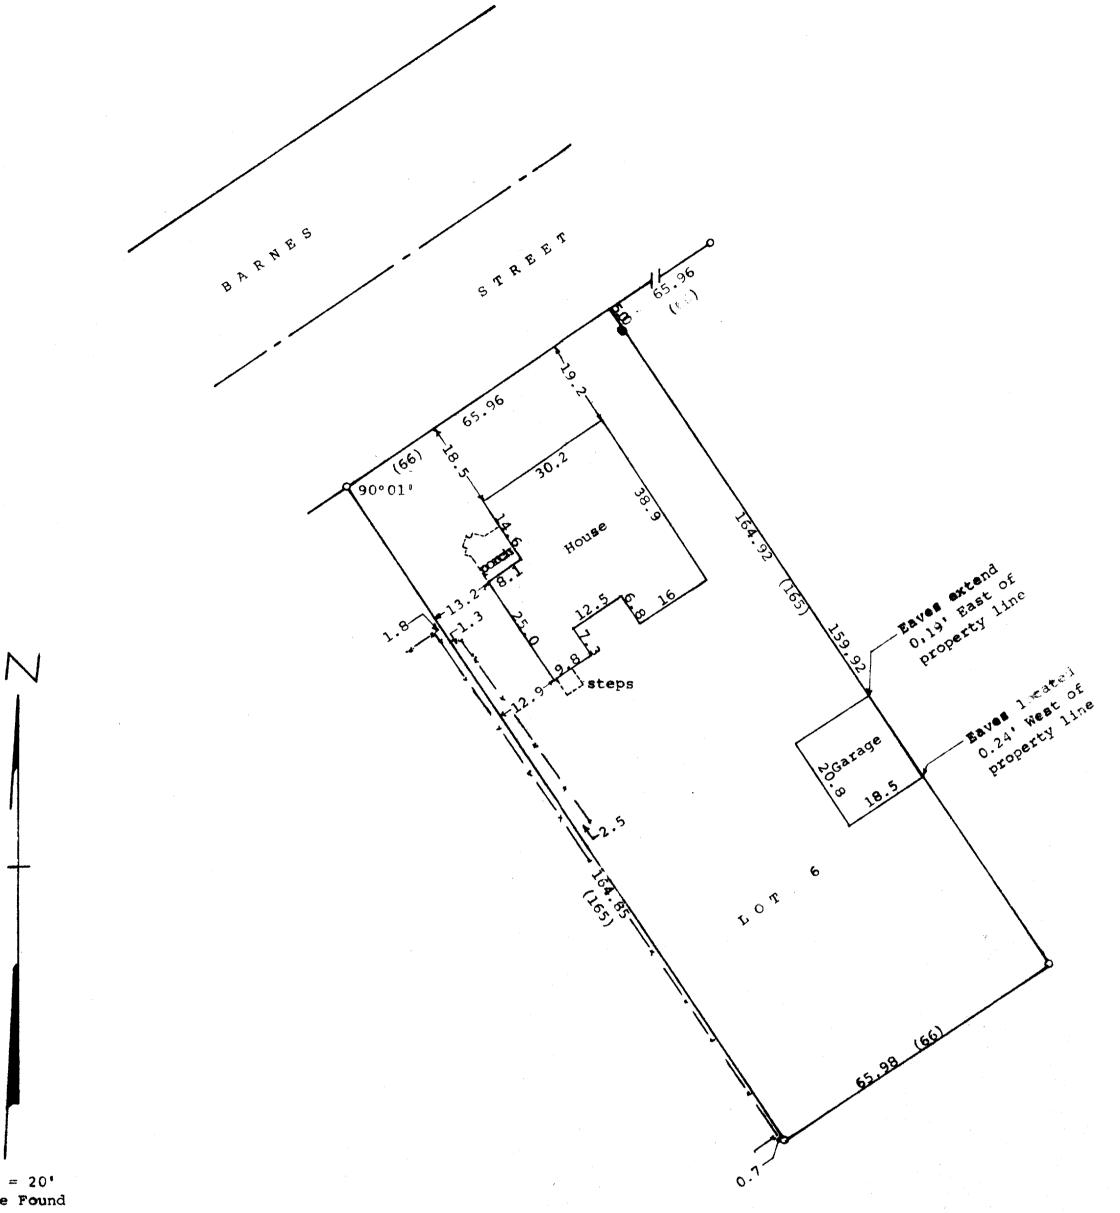

> STATE OF WISCONSIN) SS COUNTY OF WALWORTH)

I, George T. Dunham, Surveyor, certify that I have surveyed

the property described as follows:

Lot 6, Block 3 of Elmhurst Addition to the City of Delavan,

Walworth County, Wisconsin and that the map shown above is a correct representation thereof and shows the size and location of the property, its exterior boundaries, the location of all visible structures and dimensions of all principal buildings thereon, boundary fences, apparent easements, roadways and visible encreachments, if

any, and that I have surveyed the property hereon described, according to the official records, to the best of my knowledge and belief.

June 4, 2001

George T. Dunham, Surveyor



