
DUNHAM SURVEYING, S.C. SURVEYING & BURDIVIDING DELAYAN, WISCONSIN 53115

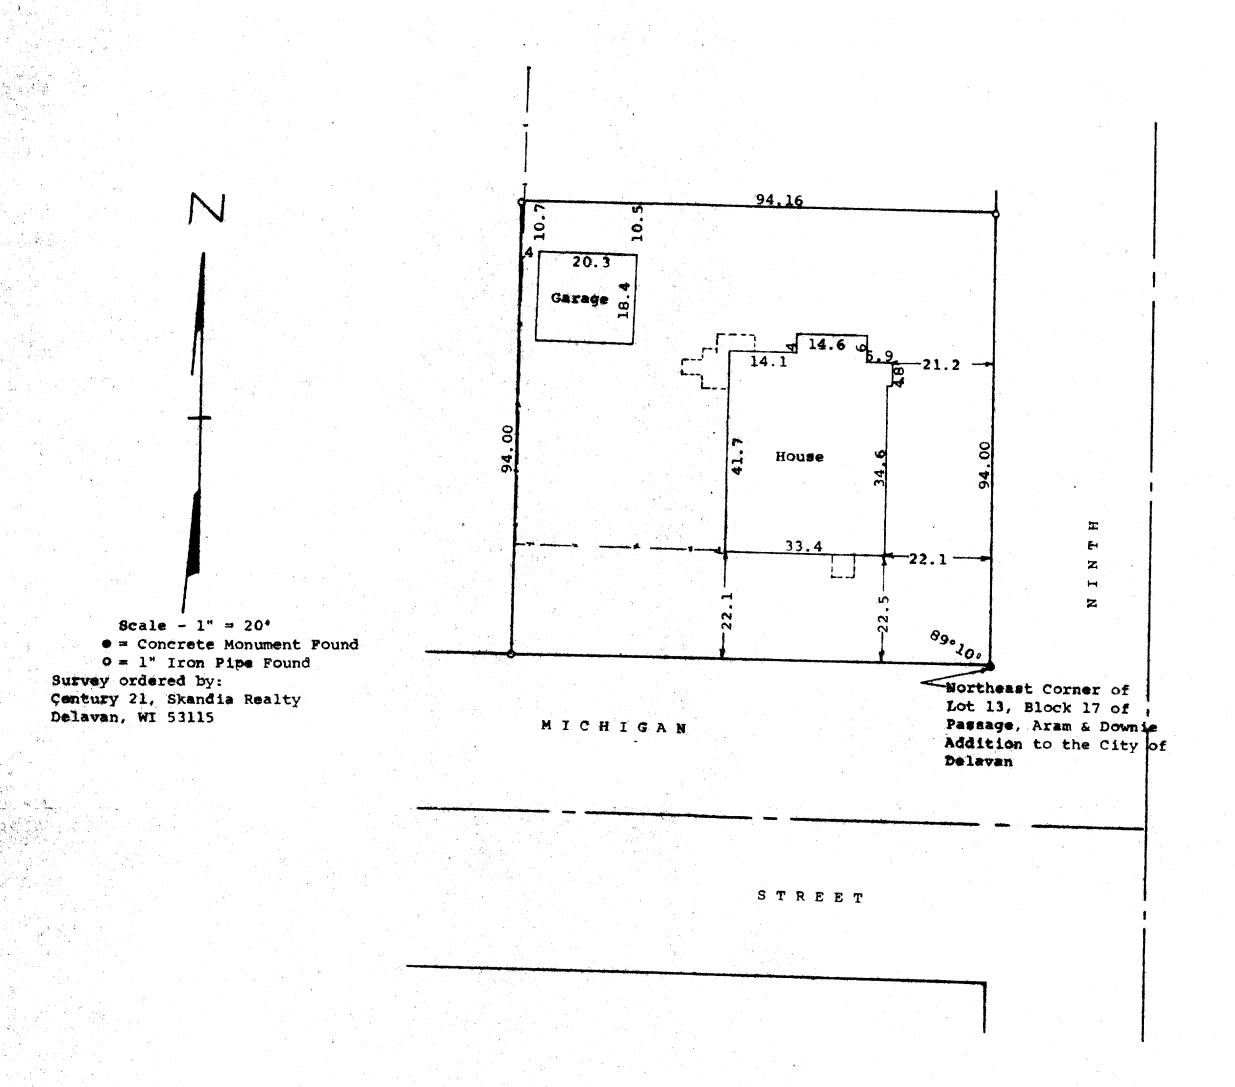

STATE OF WISCOSSIN)

COUNTY OF WALMOREN)

I, George T. Dunham, Surveyor, certify that I have surveyed the property described as follows:

Commencing at the northeast corner of Lot 13, Block 17 of Passage Aram and Downie Addition to the City of Delavan, which point of beginning is also the intersection of the west line of 9th Street and the north line of Michigan Street in said city; thence West along the north line of Michigan Street 99,16 feet; thence North parallel with the west line of 9th Street 94.00 feet; thence Bast parallel with the north line of Michigan Street 99,16 feet to the west line of 9th Street; thence south along the west line of 9th Street 94.00 feet to the place of beginning

and that the plat shown above is a correct representation thereof and shows the size and location of the property, its exterior boundaries, the location of all visible etructures and dimensions of all principal buildings thereon, boundary females, apparent easements, roadways and visible encroachments, if any, and that I have surveyed the property hereon described, according to the official records, to the best of my knowledge and belief. Rovember 19, 1999

George To Dunham, Surveyor



