ABELL SURVEYING & MAPPING

1140 SEQUOIA STREET . DELAVAN, WISCONSIN 53115 262-728-6737 LOT IRON PIPE FOUND 2.00' WEST OF CORNER ON LINE, CONCRETE SIDEWALK AT CORNER. LANDSCAPE TIMBERS 0.9'-2.1' NORTH OF LINE 165.33 HOUSE CORNERS 0.9'-163.33 I.O' SOUTH OF LINE. WOOD DECK 4. HOUSE 12 LOT 4.0' CS 21.1' AREA 0.25 ACRES GARAGE DRIVE BLACKTOP 2.00 163.37 IRON PIPE FOUND 2.00' WEST OF CORNER ON LINE, CONCRETE SIDEWALK AT CORNER. (165') 165.37


PLAT OF SURVEY OF

13

LOT

LOT 12. BLOCK 11. PASSAGE, ARAM & DOWNIE'S ADDITION TO THE CITY OF DELAVAN, WALWORTH COUNTY, WISCONSIN.

ORDERED BY: HIBL'S REAL ESTATE SALES, INC. 1034B ANN STREET DELAVAN, WI 53115

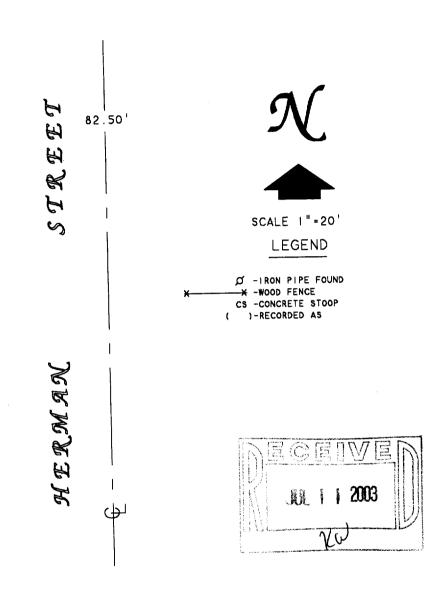

I HEREBY CERTIFY THAT I HAVE SURVEYED THE ABOVE DESCRIBED PROPERTY AND THAT THE ABOVE MAP IS A TRUE REPRESENTATION THEREOF AND SHOWS THE SIZE AND LOCATION OF THE PROPERTY, ITS EXTERIOR BOUNDARIES, THE LOCATION OF ALL VISIBLE STRUCTURES AND DIMENSIONS OF ALL PRINCIPAL BUILDINGS THEREON. BOUNDARY FENCES. APPARENT EASEMENTS, ROADWAYS AND VISIBLE ENCROACHMENTS, IF ANY, TO THE BEST OF MY KNOWLEDGE AND BELIEF.

THIS SURVEY IS MADE FOR THE USE OF THE PRESENT OWNERS OF THE PROPERTY. AND ALSO THOSE WHO PURCHASE. MORTGAGE. OR GUARANTEE THE TITLE THERETO WITHIN ONE (I) YEAR FROM DATE HEREON.

Said 7. Phill

DAVID F. ABELL WISCONSIN REGISTERED LAND SURVEYOR, \$-1596

June 20, 2002

DATE NOTE: THIS IS NOT A CERTIFIED COPY UNLESS SEALED.