
PREPARED FOR: DIANE SHOWALTER C-21 SKANDIA 822 E GENEVA DELAVAN, WI, 53115

## PLAT OF SURVEY

- OF -

LOT 9, BLOCK 18, ANN PHOENIX ADDITION TO THE CITY OF DELAVAN, WALWORTH COUNTY, WISCONSIN.

J.K. SURVEYING INC. N3705 WILLOWBEND LANE LAKE GENEVA, WI, 53147 262-248-3697

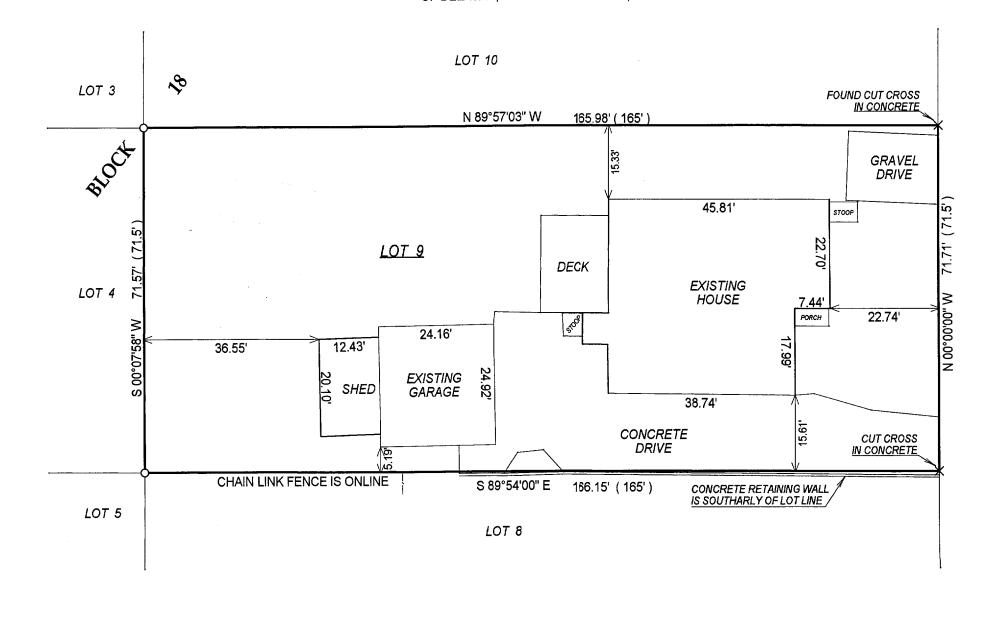

NOTE: BEARINGS ARE ASSUMED.

COMPARE LEGAL DESCRIPTION ABOVE AND DRAWING WITH DEED. FOR BUILDING RESTRICTIONS AND EASEMENTS NOT SHOWN, REFER TO DEED, ABSTRACT SOURCES AND LOCAL MUNICIPAL CODES. NOTIFY THE SURVEYOR IMMEDIATELY OF ANY DISCREPANCY.

"I hereby certify that I have surveyed the above described property and that the above map is a true representation thereof and shows the size and location of all visible structures, apparent easements and encroachments

This survey is made for the present owners of the property, and those who purchase, mortgage, or guarantee the title thereto, within one year from the date hereof.

S-2258 LAKE GENEVA,

AND SURVE

JOHN KROTT S - 2258 Wisconsin Registered Land Surveyor (original if signed in red)

(82.5' WIDE ROAD)

DATED THIS THE 9th DAY OF SEPTEMBER 2003.

= set iron bar

( )= recorded as

□ = found iron bar

= set iron pipe

= found iron pipe

SCALE 1" = 20'

JOB # 03-545

TAX ID # XPAP00013