


PLAT OF SURVEY &
TOPOGRAPHICAL MAPPING
PART OF THE SE 1/4 OF SECTION 17
TOWN 2 NORTH, RANGE 16 EAST
CITY OF DELAVAN
WALWORTH COUNTY, WISCONSIN

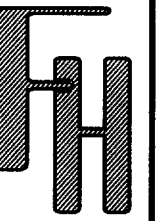

WORK ORDERED BY -
MIKE JANZEN
333 ROBBINS RUN
BURLINGTON, WI 53105

FARRIS, HANSEN & ASSOCIATES, INC.
Engineering, Architecture, Surveying
7 Ridgway Court P.O. Box 437
ELKHORN, WISCONSIN 53121
Office: (262) 723-2098
Fax: (262) 723-5866

REVISIONS
06/13/2003
ADD TOPO
FEATURES

PROJECT NO.
5317
DATE:
07-13-99
SHEET NO.
1 OF 1

LEGEND

- = FOUND IRON PIPE STAKE
- = FOUND IRON REBAR STAKE
- ⊙ = SET IRON REBAR STAKE
- = POWER POLE
- = HYDRANT
- ⊗ = FOUND CHISELED "X"
- (xxx) = RECORDED AS

LEGAL DESCRIPTION

A PARCEL OF LAND LOCATED IN THE CITY OF DELAVAN, WALWORTH COUNTY, WISCONSIN, BEING A PART OF BLOCK 15 OF PASSAGE, ARAM, AND DOWNIE SUBDIVISION, AND AN UNPLATTED PARCEL MORE PARTICULARLY DESCRIBED AS FOLLOWS:
BEGINNING AT THE NORTHEAST CORNER OF LOT 11 OF BLOCK 15 OF PASSAGE, ARAM, AND DOWNIE SUBDIVISION; THENCE S 28DEG 53MIN 25SEC E, 59.78 FEET TO THE SOUTHEAST CORNER OF SAID LOT 11; THENCE N 60DEG 52MIN 34SEC E, 99.98 FEET; THENCE S 29DEG 01MIN 36SEC E, 96.49 FEET TO THE NORTH LINE OF LANDS NOW OR FORMERLY KNOWN AS THE CHICAGO, MILWAUKEE, ST. PAUL, AND PACIFIC RAILROAD PROPERTY; THENCE S 61DEG 05MIN 00SEC W, 250.05 FEET ALONG SAID RAILROAD PARCEL TO THE NORTHEAST LINE OF SEVENTH STREET; THENCE N 29DEG 01MIN 10SEC W, 140.74 FEET; THENCE N 15DEG 58MIN 38SEC E, 21.20 FEET TO THE SOUTHEAST LINE OF WISCONSIN STREET; THENCE N 61DEG 00MIN 54SEC E, 135.20 FEET TO THE POINT OF BEGINNING. CONTAINING 32,905 SQUARE FEET (0.76 AC.) OF LAND MORE OR LESS.


NOTE: COPIES OF THIS MAP TO WHICH THE FOLLOWING CERTIFICATE WILL APPLY SHOW SURVEYOR'S ORIGINAL SEAL AND SIGNATURE IN RED INK. COPIES BY ANY OTHER MEANS MAY HAVE ALTERATIONS WHICH DO NOT REPRESENT THE SURVEYOR'S WORK PRODUCT.

I HEREBY CERTIFY THAT THE ABOVE DESCRIBED PROPERTY HAS BEEN SURVEYED UNDER MY DIRECTION AND THAT THE ABOVE MAP IS A TRUE REPRESENTATION THEREOF AND SHOWS THE SIZE AND LOCATION OF THE PROPERTY AND ITS EXTERIOR BOUNDARIES. THIS SURVEY IS MADE FOR THE USE OF THE PRESENT OWNERS OF THE PROPERTY, AND ALSO THOSE WHO PURCHASE, MORTGAGE, OR GUARANTEE THE TITLE THERETO WITHIN ONE YEAR FROM THE DATE HEREOF.


DATED: 08/01/2000

REVISED 10-21-2003
TO SHOW SIZE & LOCATION OF
AS BUILT BUILDING

PETER S. GORDON R.L.S. 2101

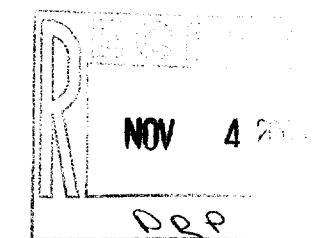

MAP SCALE IN FEET ORIGINAL 1" = 30'

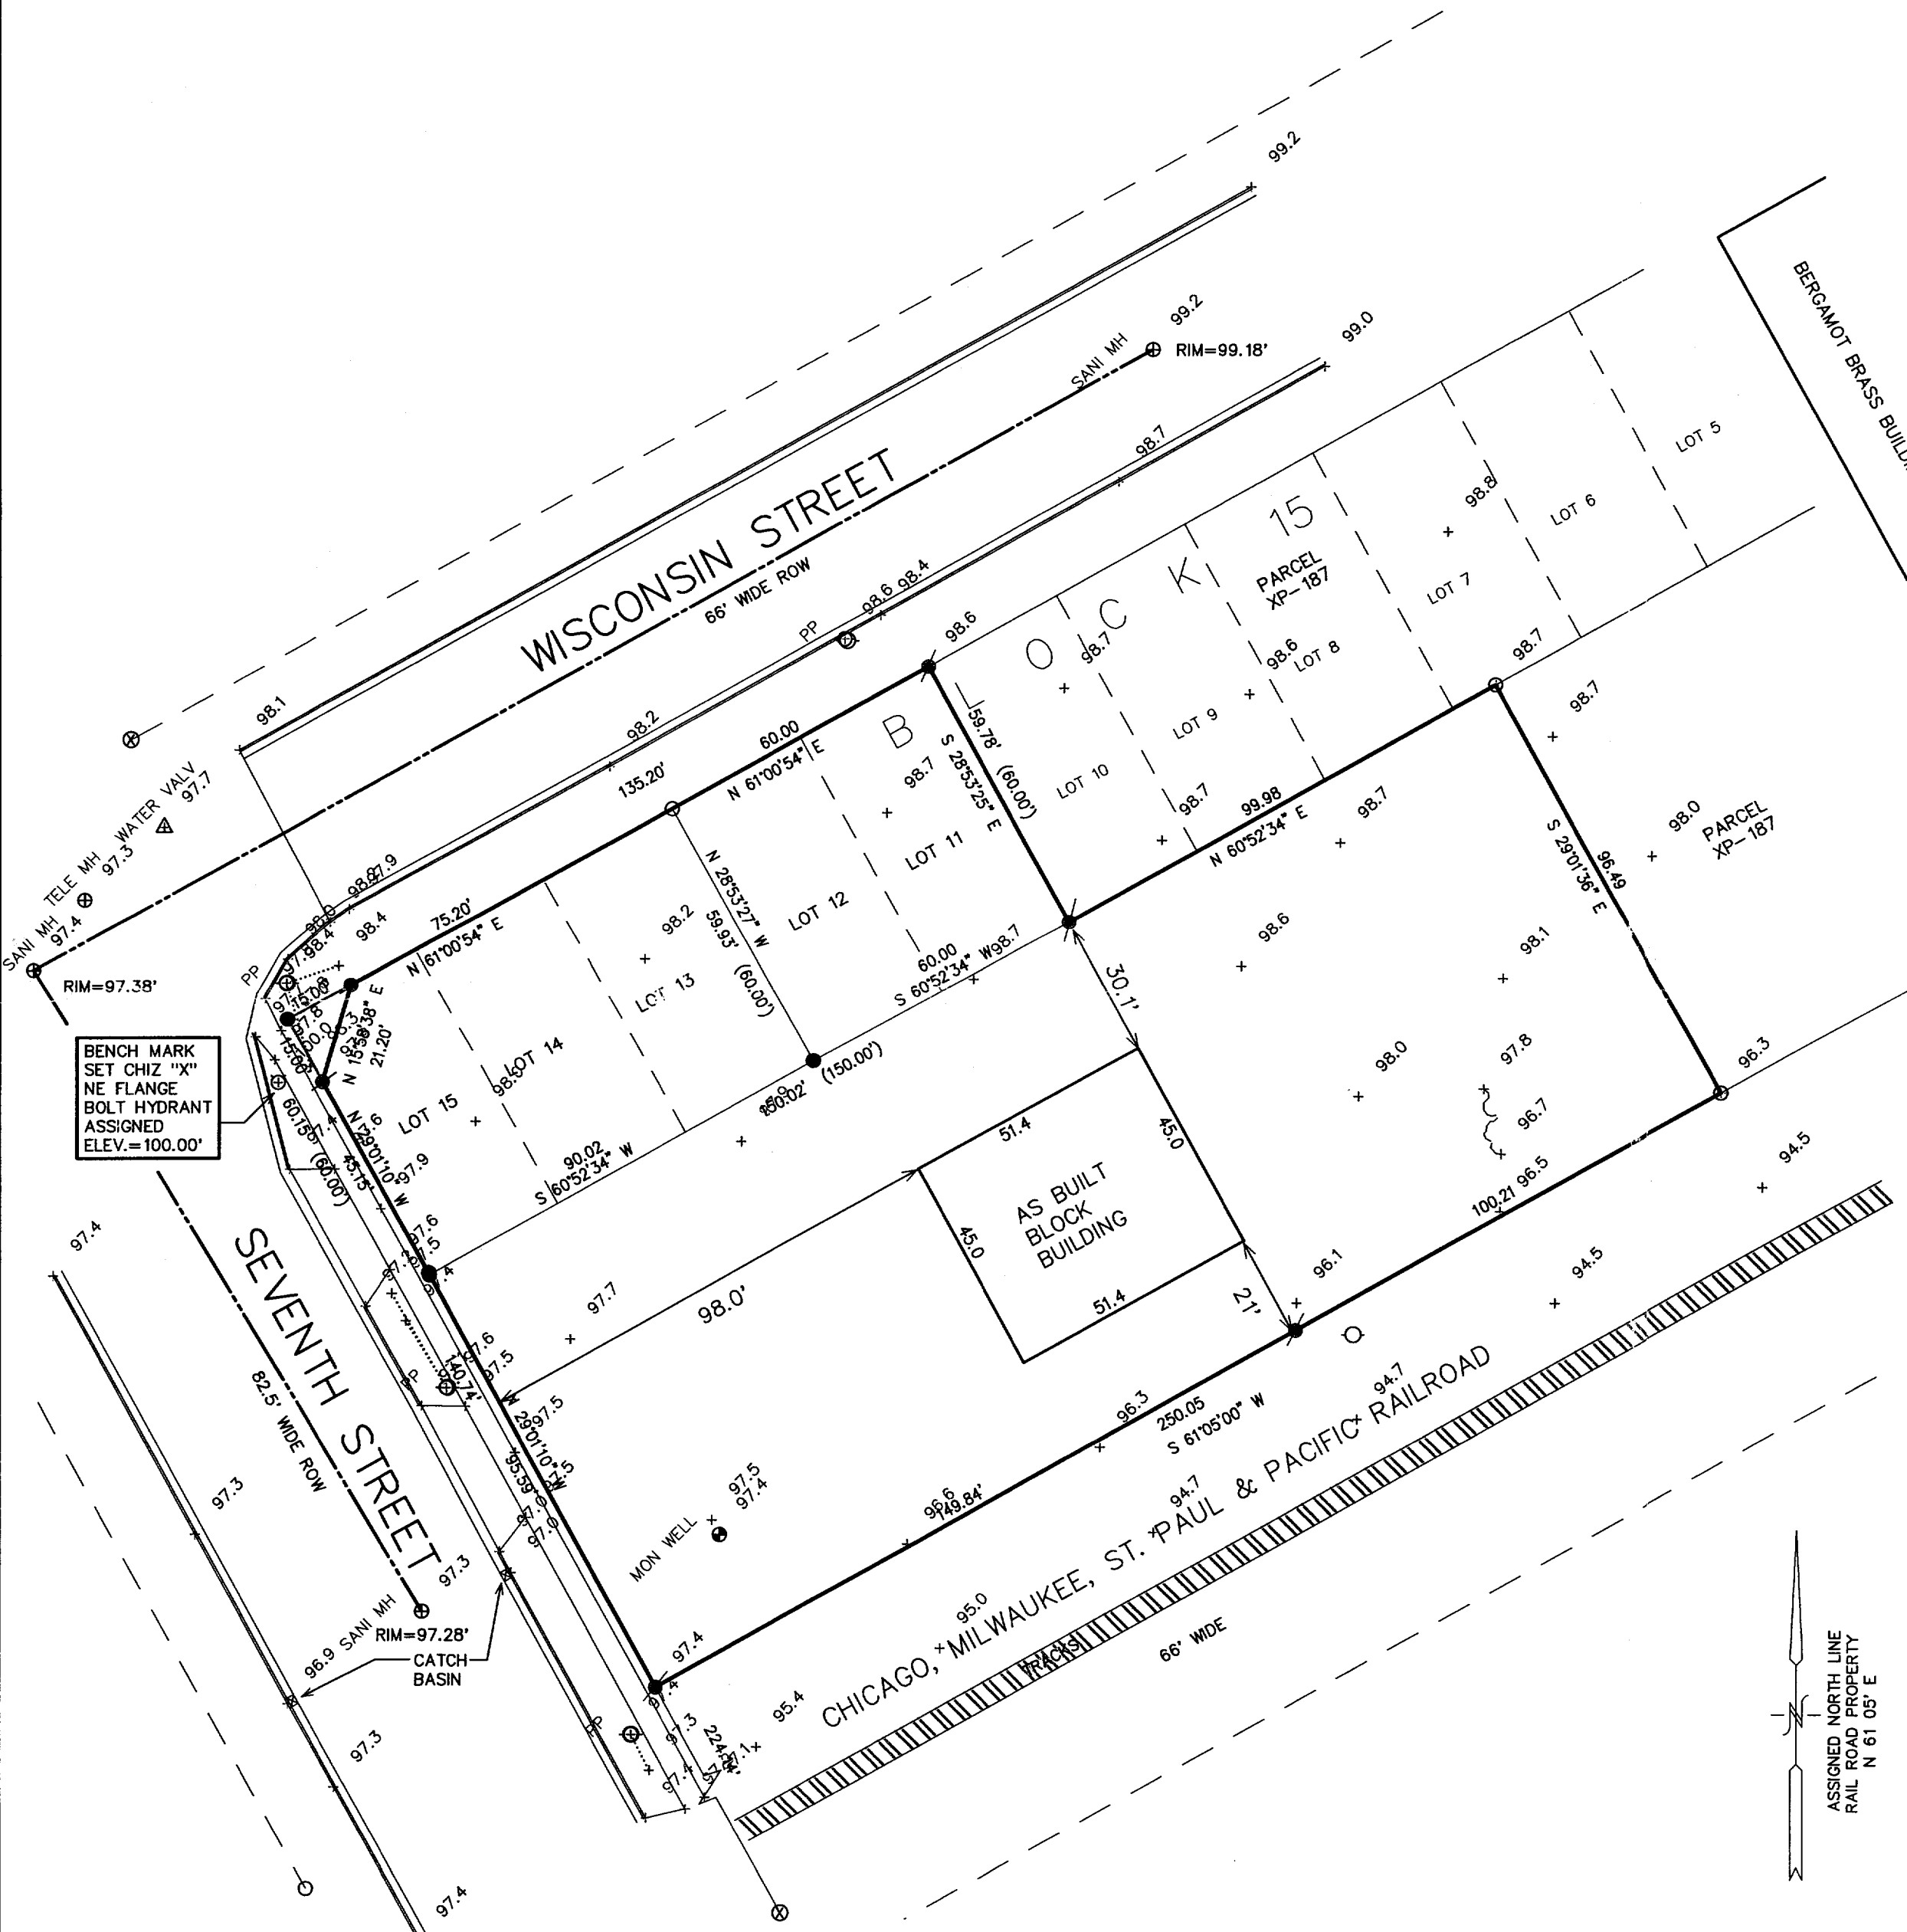

XP-188
XRXX-2A

002-2188