

NOTE: BEARINGS ARE REFERENCED TO  
EXISTING SURVEY RECORDS.




SCALE 1"=20'

LEGEND

- - IRON PIPE FOUND
- - CONCRETE MONUMENT FOUND
- △ - UTILITY POLE
- - UTILITY PED.
- - OVERHEAD UTILITY LINES
- \* - WOOD FENCE
- \*\* - CHAINLINK FENCE
- ( ) - RECORDED AS

MAIN STREET  
82.50 FEET WIDE

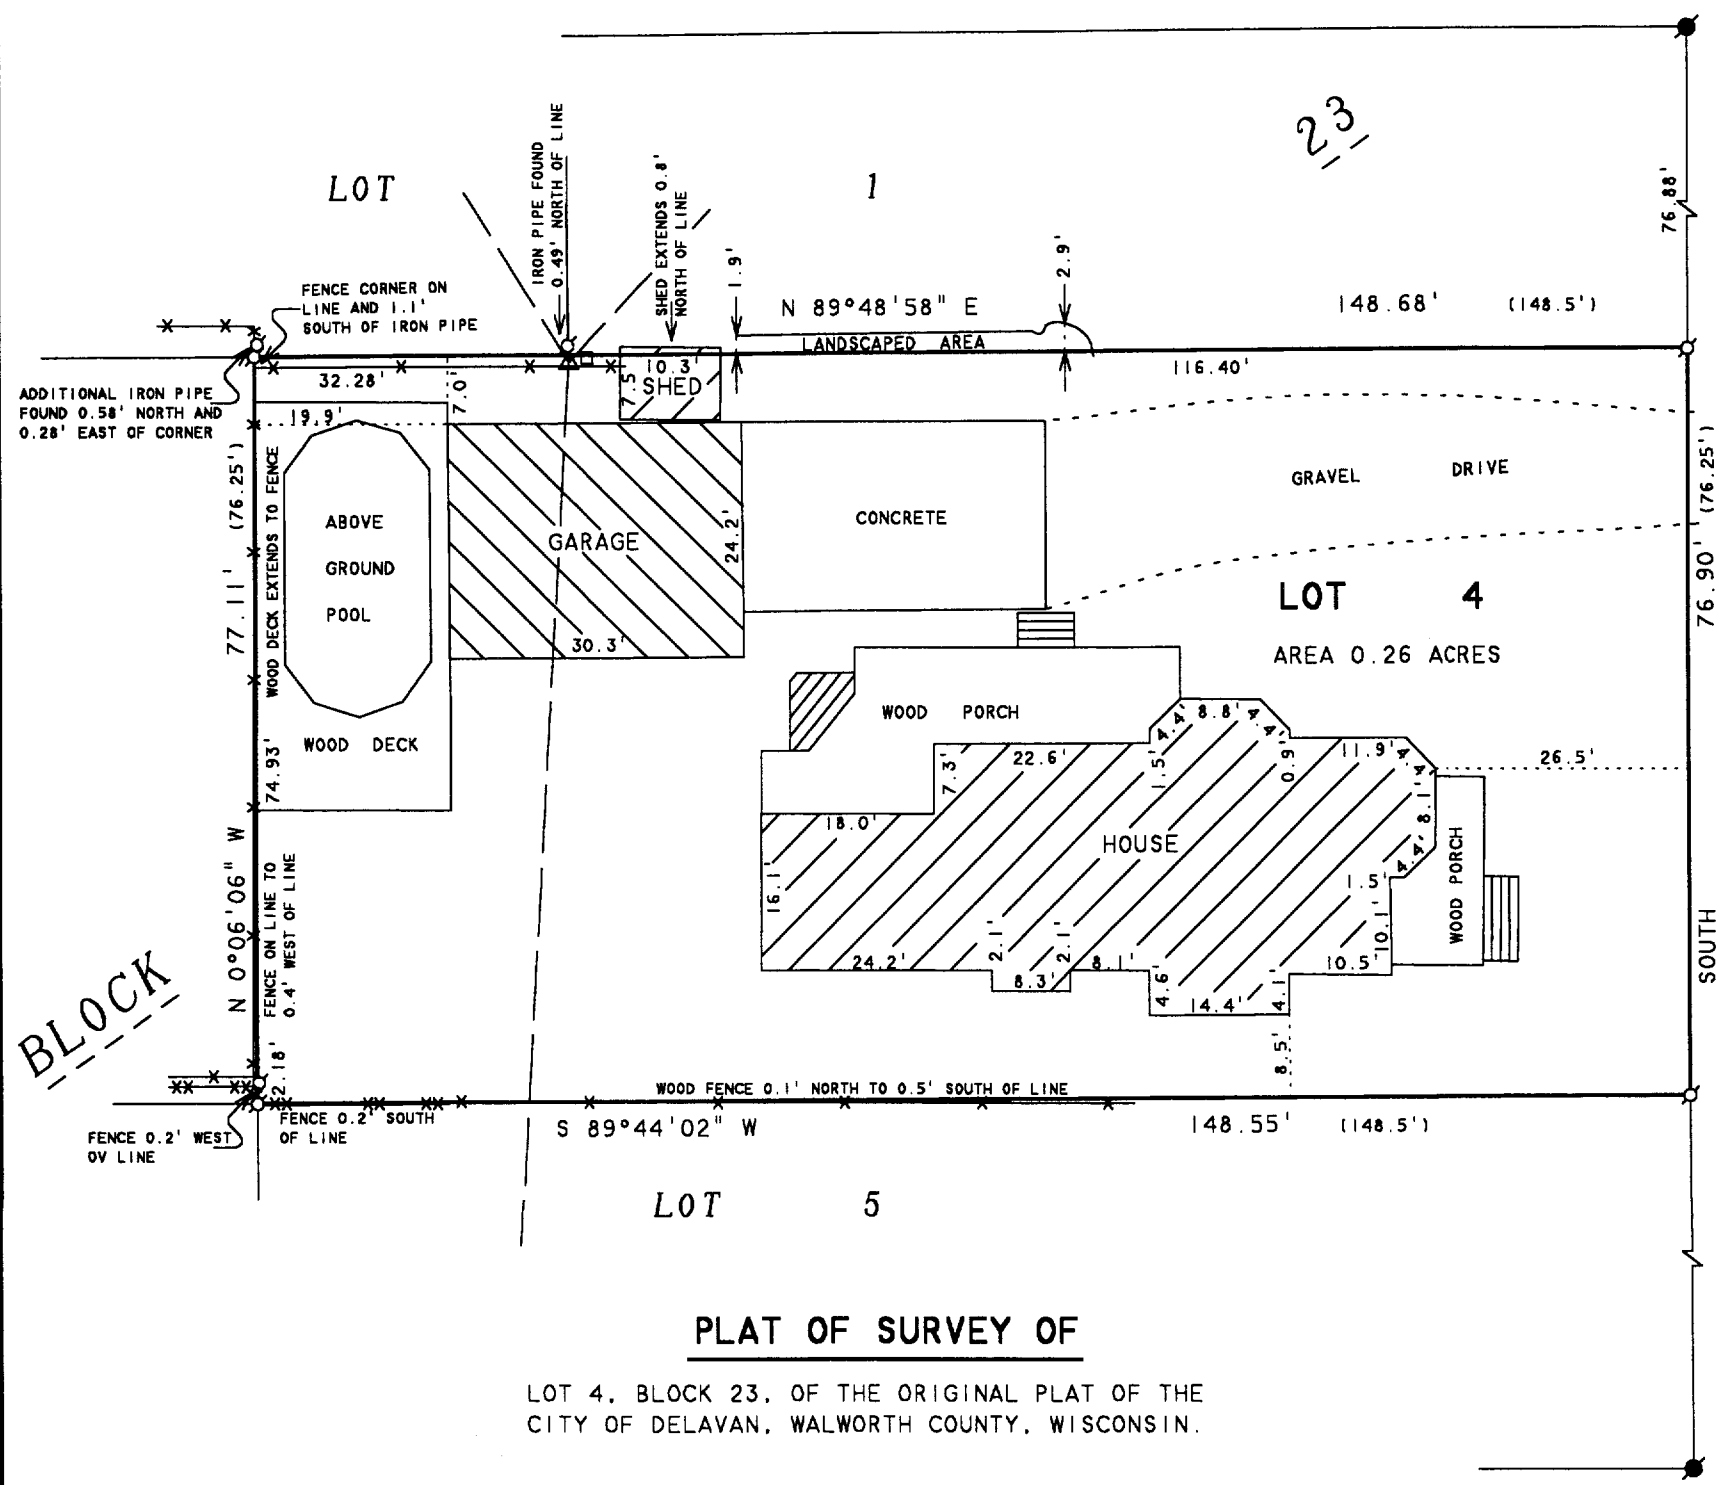

PLAT OF SURVEY OF

LOT 4, BLOCK 23, OF THE ORIGINAL PLAT OF THE  
CITY OF DELAVAN, WALWORTH COUNTY, WISCONSIN.

FEB 2

DRP

I HEREBY CERTIFY THAT I HAVE SURVEYED THE ABOVE DESCRIBED PROPERTY AND THAT THE ABOVE MAP IS A TRUE REPRESENTATION THEREOF AND SHOWS THE SIZE AND LOCATION OF THE PROPERTY, ITS EXTERIOR BOUNDARIES, THE LOCATION OF ALL VISIBLE STRUCTURES AND DIMENSIONS OF ALL PRINCIPAL BUILDINGS THEREON, BOUNDARY FENCES, APPARENT EASEMENTS, ROADWAYS AND VISIBLE ENCROACHMENTS, IF ANY, TO THE BEST OF MY KNOWLEDGE AND BELIEF.

THIS SURVEY IS MADE FOR THE USE OF THE PRESENT OWNERS OF THE PROPERTY, AND ALSO THOSE WHO PURCHASE, MORTGAGE, OR GUARANTEE THE TITLE THERETO WITHIN ONE (1) YEAR FROM DATE HEREON.

*David F. Abell*

DAVID F. ABELL  
WISCONSIN REGISTERED LAND SURVEYOR, S-1596

ORDERED BY: RE/MAX-LAKES AREA REALTORS  
1815 N. SHORE DRIVE  
DELAVAN, WI. 53115

September 17, 2003

DATE: JOB NUMBER - 88122A  
NOTE: THIS IS NOT A CERTIFIED COPY UNLESS SEALED.

XOP-241A

002-2199