PREPARED FOR: BRIAN AMBORN HIBL'S REAL ESTATE 1034B ANN STREET DELAVAN, WI 53115

○ = FOUND IRON PIPE

= SET IRON PIPE

■ = SET IRON BAR

TAX ID #: XEA 00043

SCALE: 1" = 30'


IOB #: 04-041

## PLAT OF SURVEY

-OF-

J.K. SURVEYING INC. N3705 WILLOWBEND LANE LAKE GENEVA, WI 53147 (262) 248-3697

THE EAST 33 FEET OF LOT 14 AND LOT 15, BLOCK 4 OF ELMHURST SUDIVISION, A SUDIVISION LYING AND BEING IN THE CITY OF DELAVAN, WALWORTH COUNTY, WISCONSIN.

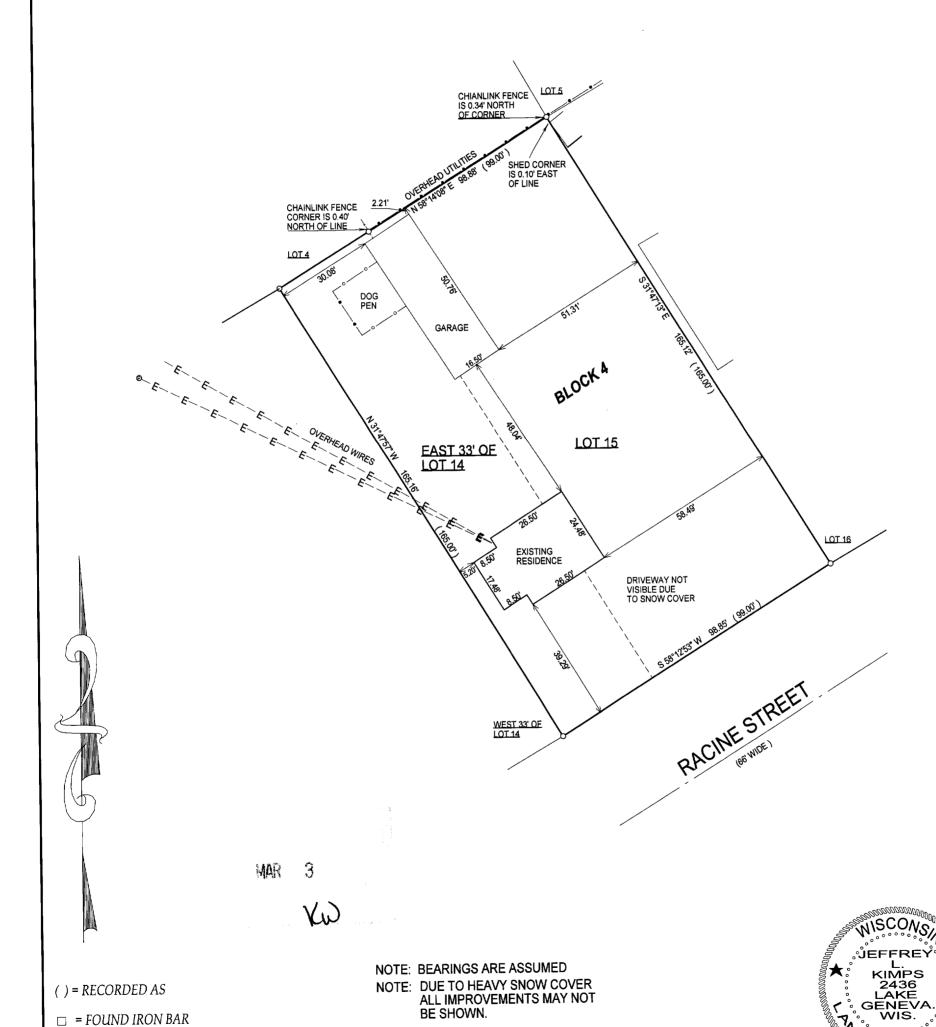

COMPARE LEGAL DESCRIPTION ABOVE AND DRAWING WITH DEED. FOR BUILDING RESTRICTIONS AND EASEMENTS NOT SHOWN, REFER TO DEED, ABSTRACT SOURCES AND LOCAL MUNICIPAL CODES. NOTIFY THE SURVEYOR IMMEDIATELY OF ANY DISCREPANCY.

"I hereby certify that the above described property was surveyed under my supervision and that the above map, to the best of my knowledge and

belief, is a true representation thereof and shows the size and location of all

visible structures, apparent easements and encroachments if any."

This survey is made for the present owners of the property, and those who purchase, mortgage, or guarentee the title thereto, within one year from

the date hereof.

JEFFREY L KIMPS \$ 2436 Wisconsin Registered Land Surveyor

(original if signed in red)

DATED THE 10 TH, DAY OF FEBRUARY 2004.

SURVE