
ABELL SURVEYING & MAPPING

1140 SEQUOIA STREET . DELAVAN, WISCONSIN 53115 262-728-6737

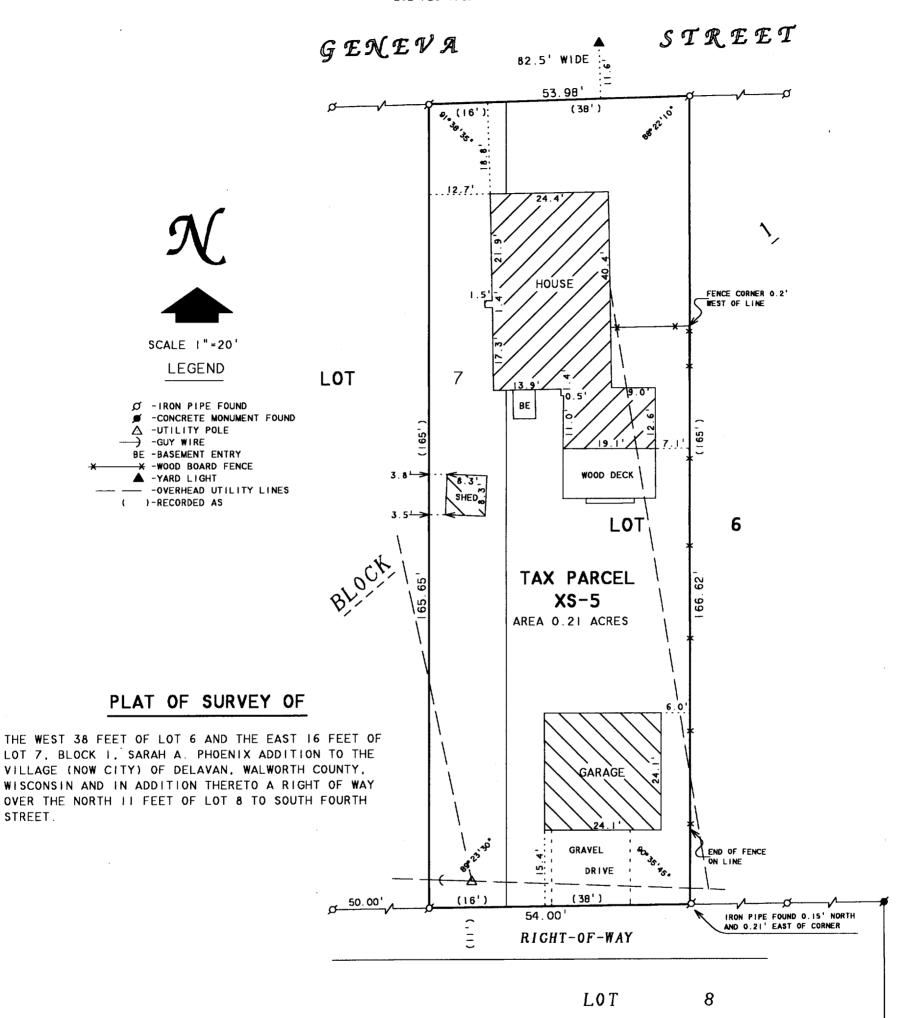

I HEREBY CERTIFY THAT I HAVE SURVEYED THE ABOVE DESCRIBED PROPERTY AND THAT THE THEREBY CERTIFY THAT I HAVE SURVEYED THE ABOVE DESCRIBED PROPERTY AND THAT IF ABOVE MAP IS A TRUE REPRESENTATION THEREOF AND SHOWS THE SIZE AND LOCATION OF THE PROPERTY, ITS EXTERIOR BOUNDARIES, THE LOCATION OF ALL VISIBLE STRUCTURES AND DIMENSIONS OF ALL PRINCIPAL BUILDINGS THEREON, BOUNDARY FENCES, APPARENT EASEMENTS, ROADWAYS AND VISIBLE ENCROACHMENTS, IF ANY, TO THE BEST OF MY KNOWLEDGE AND BELIEF

THIS SURVEY IS MADE FOR THE USE OF THE PRESENT OWNERS OF THE PROPERTY, AND ALSO THOSE WHO PURCHASE, MORTGAGE, OR GUARANTEE THE TITLE THERETO WITHIN ONE (I) YEAR FROM DATE HEREON.

ORDERED BY: RE/MAX-LAKES AREA REALTORS 1815 N. SHORE DRIVE DELAVAN, WI. 53115

DAVID F. ABELL WISCONSIN REGISTERED LAND SURVEYOR, 5-1596

March 4, 2005 DATE JOB NUMBER - NOTE: THIS IS NOT A CERTIFIED COPY UNLESS SEALED

92104A

0005

STREET.