PREPARED FOR: RODNEY WHETLOW KEEFE REAL ESTATE, INC. 751 GENEVA PARKWAY LAKE GENEVA, WI


PLAT OF SURVEY


- OF -

A PARCEL OF LAND LOCATED IN THE NORTHEAST 1/4 OF SECTION 19,T.2.N., R.16.E. CITY OF DELAVAN, WALWORTH COUNTY, WISCONSIN. DESCRIBED AS FOLLOWS: TO-WIT: COMMENCING AT THE INTERSECTION OF THE NORTH LINE OF PHOENIX STREET AND THE CENTERLINE OF SOUTH 2nd STREET IN SAID CITY OF DELAVAN; THENCE SOUTH ALONG THE CENTERLINE OF SAID SOUTH 2nd STREET 1885.0 FEET TO THE PLACE OF BEGINNING; THENCE EAST 613.14 FEET TO THE NORTH-SOUTH 1/8th SECTION LINE OF SAID NORTHEAST 1/4 OF SECTION 19; THENCE NORTH ALONG SAID 1/8th SECTION LINE 142.56 FEET; THENCE WEST 613.14 FEET TO THE CENTERLINE OF SAID SOUTH 2nd STREET; THENCE SOUTH ALONG SAID CENTERLINE 142.56 FEET TO THE PLACE OF BEGINNING.

PATHFINDER SURVEYING, INC. N3705 WILLOWBEND LANE LAKE GENEVA, WI, 53147 262-248-3697

OEC 1.4

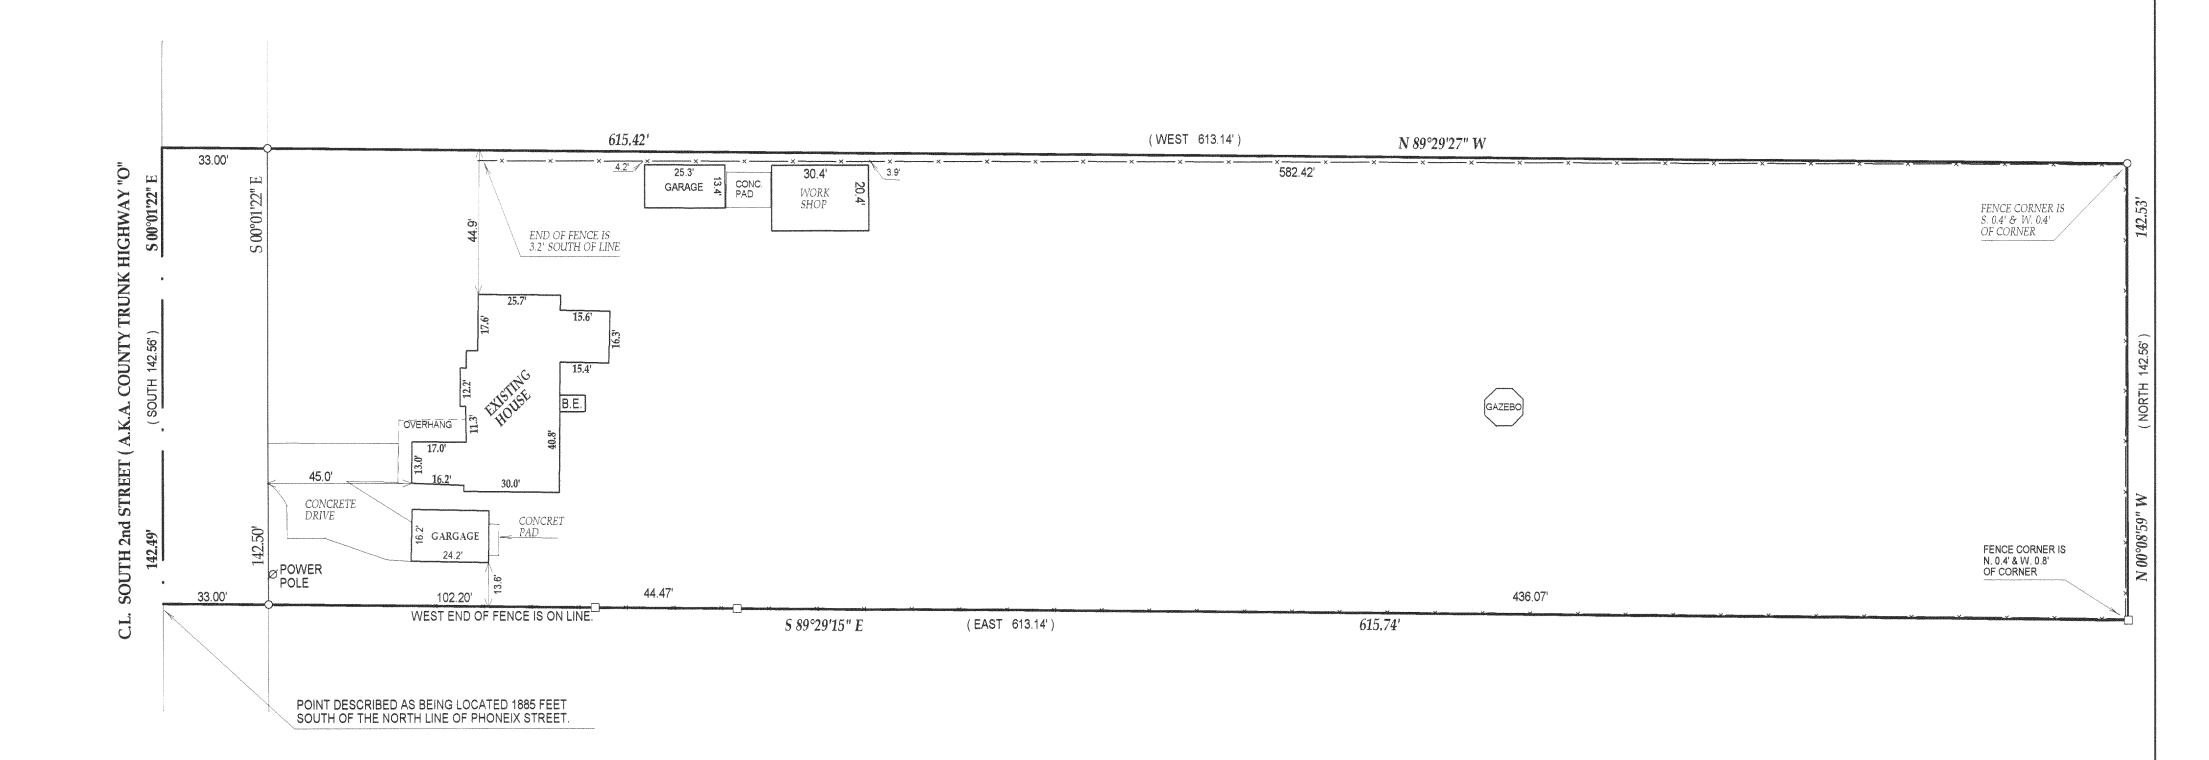

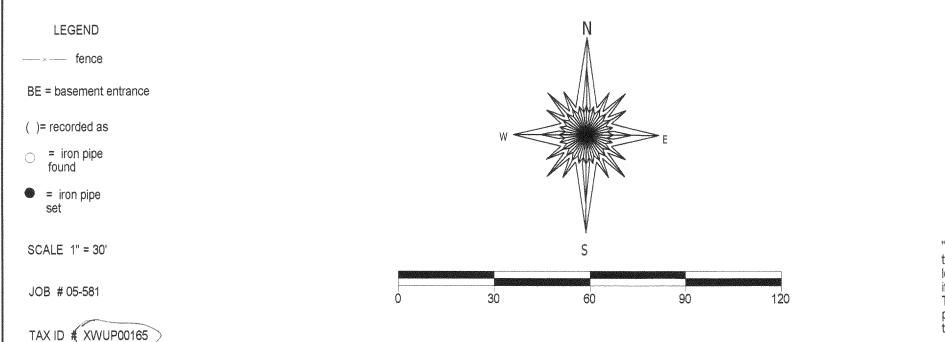

COMPARE LEGAL DESCRIPTION ABOVE AND DRAWING WITH DEED. FOR BUILDING RESTRICTIONS AND EASEMENTS NOT SHOWN, REFER TO DEED, ABSTRACT SOURCES AND LOCAL MUNICIPAL CODES. NOTIFY THE SURVEYOR IMMEDIATELY OF ANY DISCREPANCY.

"I hereby certify that I have surveyed the above described property and that the above map is a true representation thereof and shows the size and location of all visible structures, apparent easements and encroachments

This survey is made for the present owners of the property, and those who purchase, mortgage, or guarentee the title thereto, within one year from

DATED THIS 3rd , DAY OF NOVEMBER, 2005

JOHN P

KROTT

S-2258

LAKE GENEVA