

ABELL SURVEYING & MAPPING 1140 SEQUOIA STREET · DELAVAN. WISCONSIN 53115 262-728-6737 LOT 17



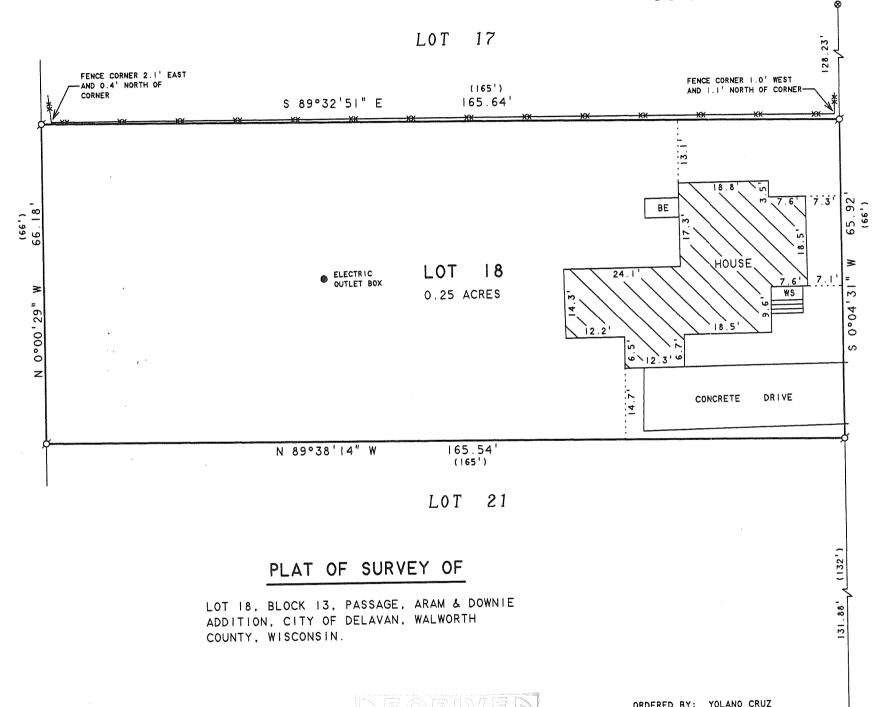

EIGHTH STREET

NOTE: BEARINGS ARE REFERENCED TO EXISTING SURVEY RECORDS.

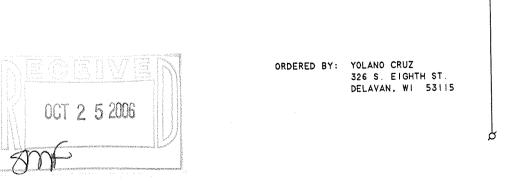



SCALE | " = 20 '

LEGEND

Ø - IRON PIPE FOUND

⊗ - CUTCROSS IN CONCRETE FOUND

WS - WOOD STOOP

I HEREBY CERTIFY THAT I HAVE SURVEYED THE ABOVE DESCRIBED PROPERTY AND THAT THE ABOVE MAP IS A TRUE REPRESENTATION THEREOF AND SHOWS THE SIZE AND LOCATION OF THE PROPERTY, ITS EXTERIOR BOUNDARIES, THE LOCATION OF ALL VISIBLE STRUCTURES AND DIMENSIONS OF ALL PRINCIPAL BUILDINGS THEREON, BOUNDARY FENCES, APPARENT EASEMENTS, ROADWAYS AND VISIBLE ENCROACHMENTS, IF ANY, TO THE BEST OF MY KNOWLEDGE AND BELIEF

THIS SURVEY IS MADE FOR THE USE OF THE PRESENT OWNERS OF THE PROPERTY, AND ALSO THOSE WHO PURCHASE, MORTGAGE, OR GUARANTEE THE TITLE THERETO WITHIN ONE (I) YEAR FROM DATA HEREON.

David 7. Abl

DAVID F. ABELL WISCONSIN REGISTERED LAND SURVEYOR, S-1596

August 16, 2006

JOB NUMBER - 06078

NOTE: THIS IS NOT A CERTIFIED COPY UNLESS SEALED.