

ORDERED BY: NANCY DUPONT

115 FRANKLIN STREET

DELAVAN, WI 53115


NOTE: BEARINGS ARE REFERENCED TO THE RECORDED SUBDIVISION PLAT.

PLAT OF SURVEY OF

LOT 61 AND THE EAST 1/2 OF LOT 60. MAR-DEL ESTATES, LOCATED IN THE CITY OF DELAVAN, WALWORTH COUNTY, WISCONSIN.



I HEREBY CERTIFY THAT I HAVE SURVEYED THE ABOVE DESCRIBED PROPERTY AND THAT THE ABOVE MAP IS A TRUE REPRESENTATION THEREOF AND SHOWS THE SIZE AND LOCATION OF THE PROPERTY, ITS EXTERIOR BOUNDARIES, THE LOCATION OF ALL VISIBLE STRUCTURES AND DIMENSIONS OF ALL PRINCIPAL BUILDINGS THEREON, BOUNDARY FENCES, APPARENT EASEMENTS, ROADWAYS AND VISIBLE ENCROACHMENTS, IF ANY, TO THE BEST OF MY KNOWLEDGE AND BELIEF.

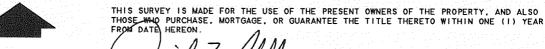

SCALE | "=30"

LEGEND

Ø -IRON PIPE FOUND CP -CONCRETE PORCH XX -CHAINLINK FENCE

)-RECORDED AS

2007

JOB NUMBER THIS IS NOT A CERTIFIED COPY UNLESS SEALED.

DAVID F. ABELL WISCONSIN REGISTERED LAND SURVEYOR, S-1596