PLAT OF SURVEY

LOT 22 OF THE FIELDS OF DELAVAN WEST, ACCORDING TO THE RECORDED PLAT THEREOF. SAID LAND BEING IN THE CITY OF DELAVAN, WALWORTH COUNTY, WISCONSIN.


SOUTHEASTERN WISCONSIN HOUSING CORPORATION SURVEY FOR:

CEDAR AVENUE PROPOSED ADDRESS:

EXISTING TOP OF FOUNDATION: 101.6



I HEREBY CERTIFY THAT THE EXISTING FOUNDATION SHOWN ON THIS PLAT OF SURVEY IS LOCATED AS SHOWN THUS (), DATED THIS 9TH DAY OF JULY, 2007.

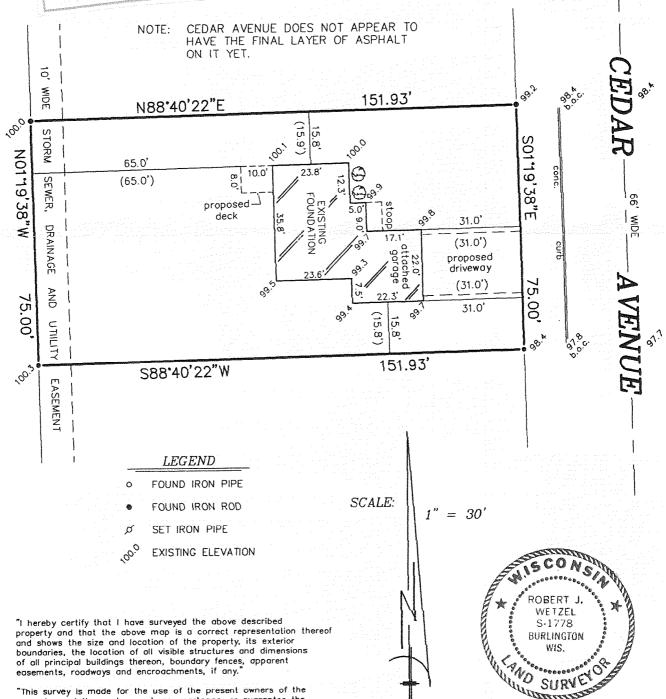

"This survey is made for the use of the present owners of the property, and those who purchase, mortgage, or guarantee the title thereto within one year from date hereof."

THIS IS NOT AN ORIGINAL PRINT UNLESS THIS SEAL IS RED.

ROBERT J. WETZEL

 U_{S-1778}

MAY 28, 2007 DATE

7584 JOB NUMBER

B.W. SURVEYING, INC.

412 N. PINE STREET BURLINGTON, WI 53105 (262) - 767 - 0225

22

1