

# CERTIFICATION OF BUILDING LOCATION









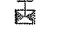
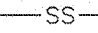
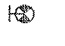




## DESCRIPTION:

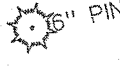
(AS TRANSCRIBED FROM WARRANTY DEED RECORDED IN VOL. 648, ON PAGE 7250, AS DOC. NO. 000360460, ON 08/01/97)

PARCEL OF LAND LOCATED IN DELAVAN BUSINESS PARK NO. 3 IN THE SW 1/4 OF THE NW 1/4 OF SECTION 15, TOWN 2 NORTH, RANGE 16 EAST, CITY OF DELAVAN, WALWORTH COUNTY, WISCONSIN, MORE PARTICULARLY DESCRIBED AS FOLLOWS:

COMMENCING AT THE NW CORNER OF BLOCK D OF SAID DELAVAN BUSINESS PARK NO. 3 BEING THE SOUTHERLY RIGHT-OF-WAY OF GREBBY STREET; THENCE N 88DEG 48MIN 20SEC E 350.00 FEET ALONG SAID RIGHT-OF-WAY OF GREBBY STREET TO THE POINT OF BEGINNING; THENCE CONTINUE N 88DEG 48MIN 20SEC E 354.20 FEET ALONG SAID SOUTHERLY RIGHT-OF-WAY; THENCE S 46DEG 12MIN 00SEC E 41.00 FEET TO THE WESTERLY RIGHT-OF-WAY OF HALLBERG STREET; THENCE S 01DEG 11MIN 40SEC E 313.02 FEET ALONG SAID WESTERLY RIGHT-OF-WAY OF HALLBERG STREET; THENCE S 88DEG 48MIN 41SEC W 383.50 FEET; THENCE N 01DEG 08MIN 33SEC W 341.97 FEET TO THE POINT OF BEGINNING. CONTAINING 3.00 ACRES OF LAND MORE OR LESS.

## LEGEND:

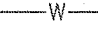(100.00') RECORDED DISTANCE	 6" PINE	CONIFEROUS TREE (TRUNK DIA. & SPECIES AS NOTED)
100.00' MEASURED DISTANCE		LIGHT POLE
 3/4" FOUND IRON ROD, UNLESS NOTED		TELEPHONE PEDASTAL
 SAN		FIRE HYDRANT
 SS		LAWN SPRINKLER HEAD
 W	 SS	EXISTING STORM SEWER
 W	 SAN	EXISTING SANITARY SEWER
 S	 W	EXISTING WATER MAIN
		

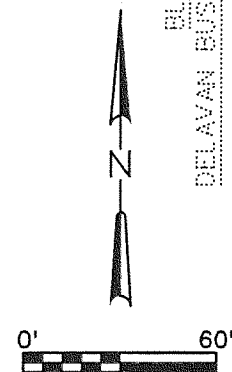

**BASIS OF BEARING:**  
THE NORTHERLY LINE OF THE PARCEL WAS TAKEN TO BEAR N88° 48' 20" E.


SURVEY DATE: 10/24/07

SURVEY MADE FOR:

PATRICK J. AND  
JEAN A. WATTS  
PO BOX 545  
WILLIAMS BAY, WI 53191

**RSV**  
ENGINEERING, INC.  
146 E. MILWAUKEE ST.  
JEFFERSON, WI 53549  
(920) 674-3411


I, PAUL H. VAN HENKELUM R.L.S. \*1931, HEREBY CERTIFY THE LOCATION OF THE PROPOSED BUILDING AS SHOWN ON THIS SURVEY MAP. I FURTHER CERTIFY THAT THE SURVEY AND MAP HAVE BEEN PREPARED UNDER MY DIRECTION AND CONTROL AND IS CORRECT TO THE BEST OF MY KNOWLEDGE AND BELIEF.

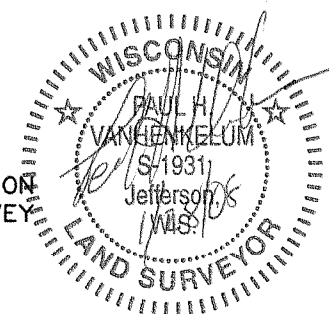

PLOT DATE: 1/29/2008

RSV JOB#: 07-584 WATTS

XGDB3-4E

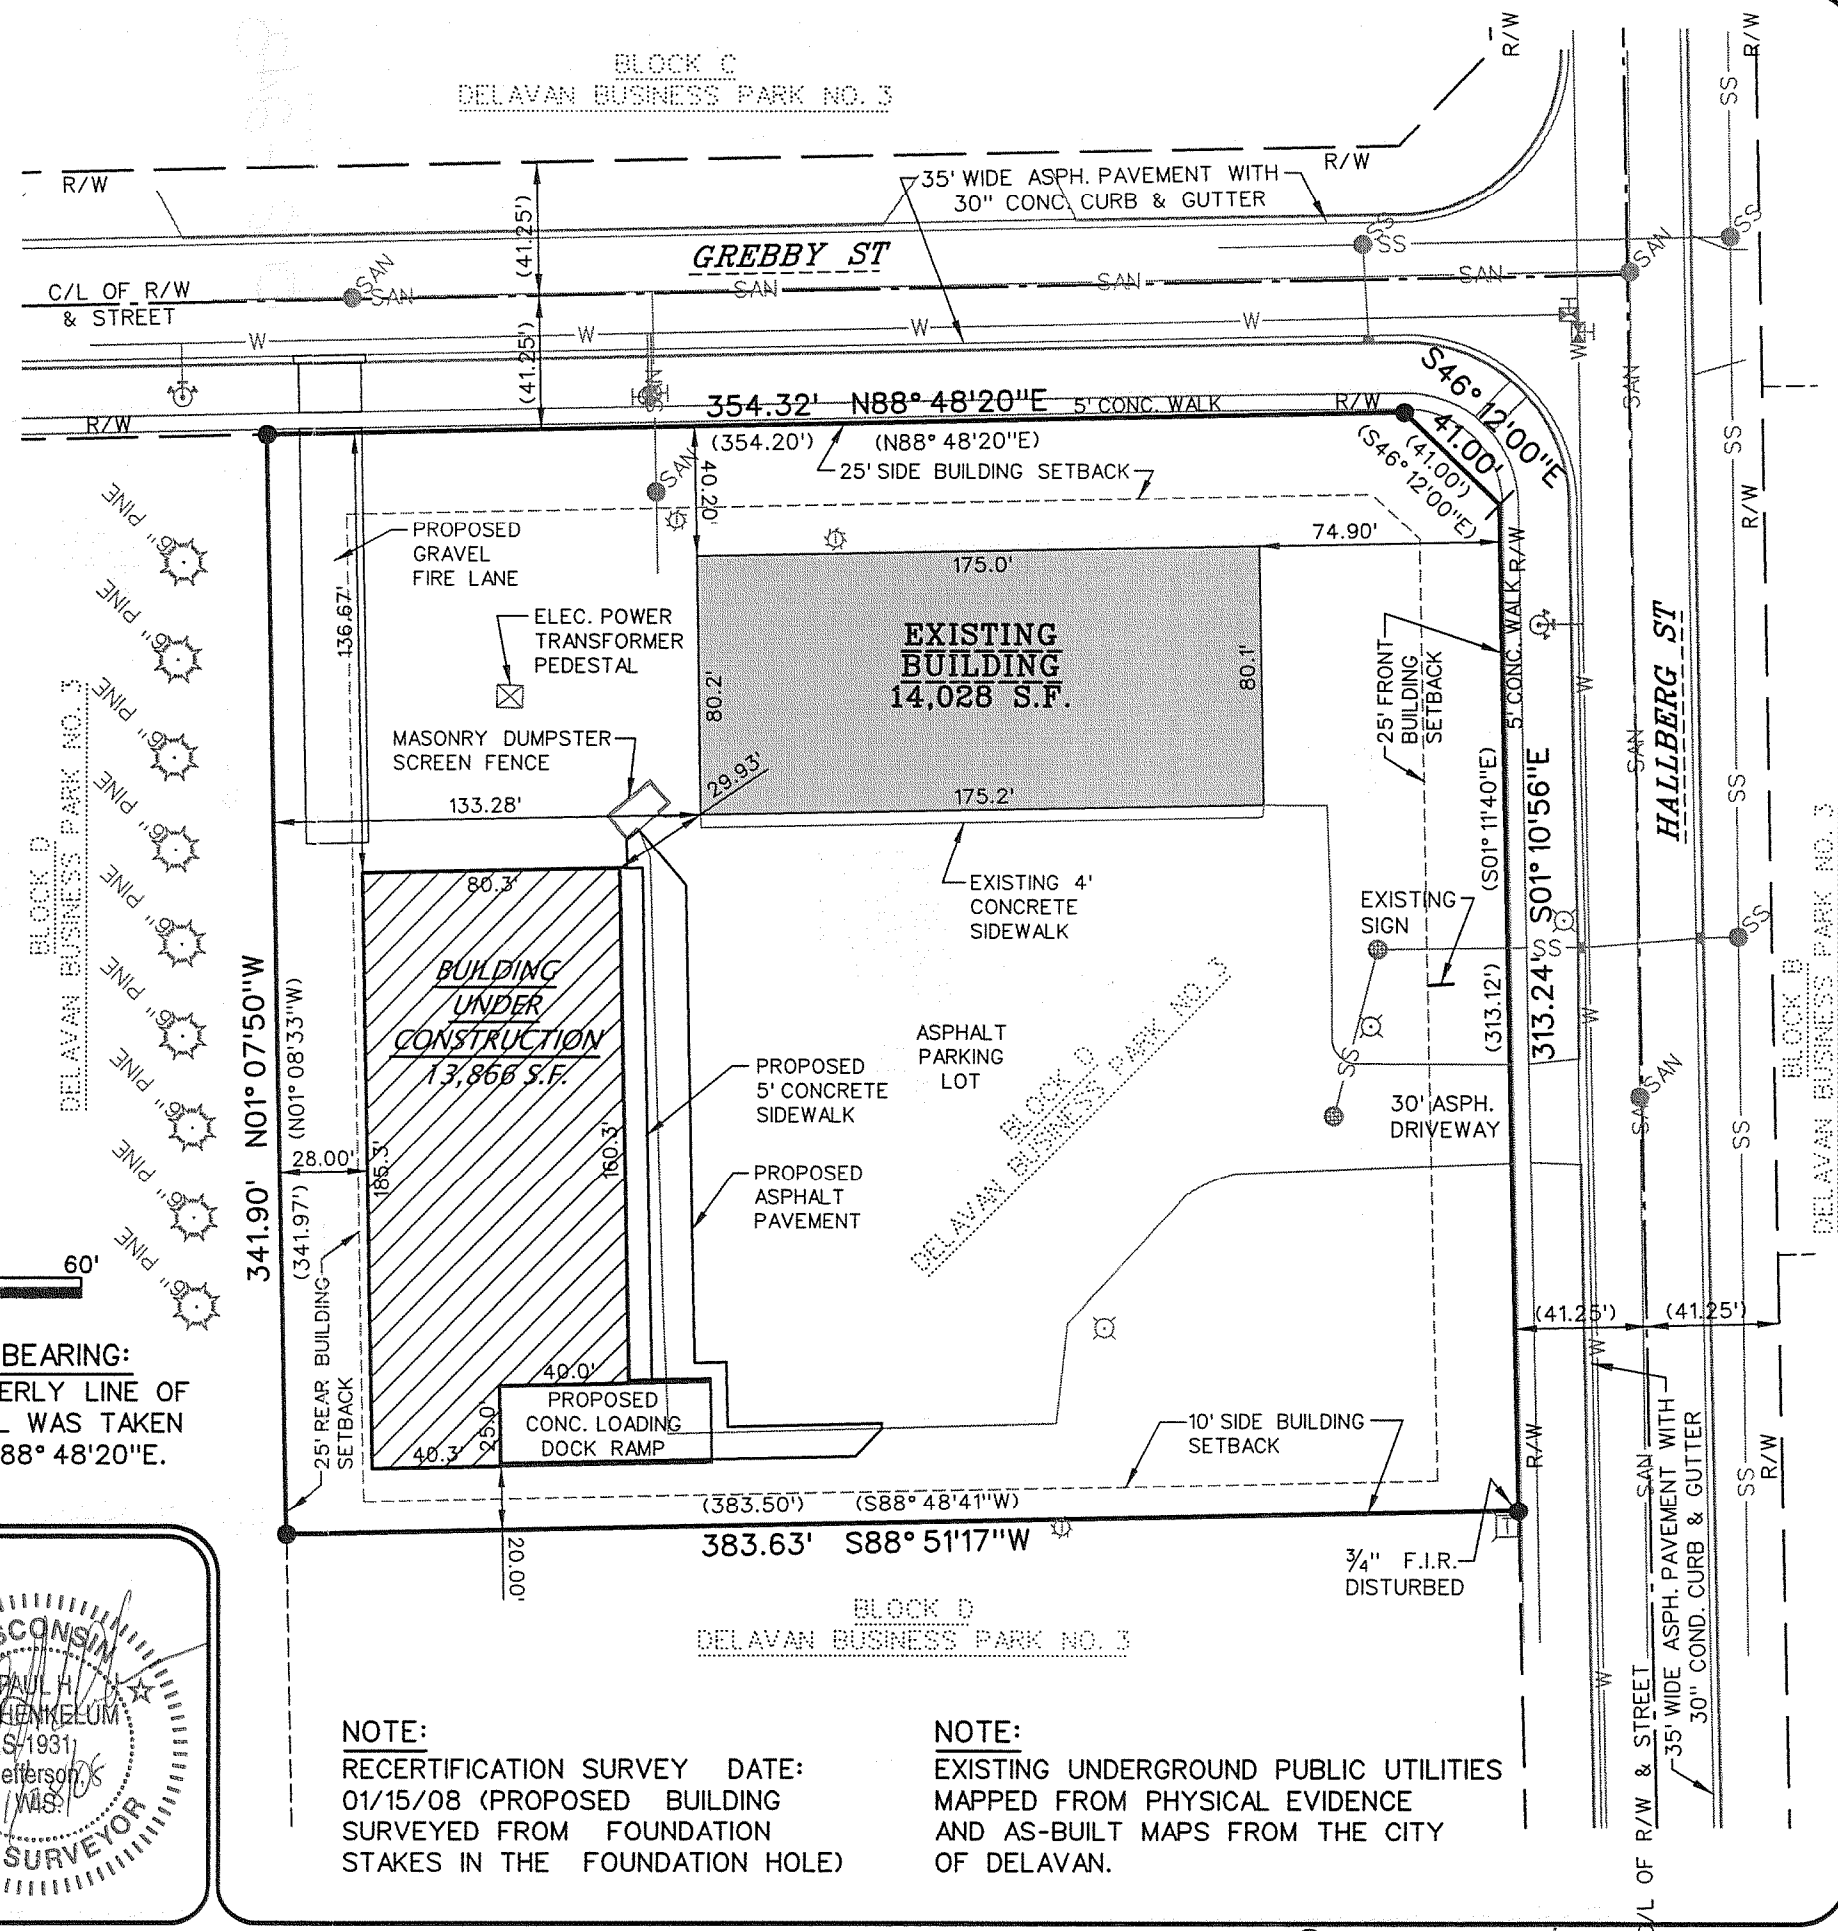

## NOTE:

RECERTIFICATION SURVEY DATE:  
01/15/08 (PROPOSED BUILDING  
SURVEYED FROM FOUNDATION  
STAKES IN THE FOUNDATION HOLE)

## NOTE:

EXISTING UNDERGROUND PUBLIC UTILITIES  
MAPPED FROM PHYSICAL EVIDENCE  
AND AS-BUILT MAPS FROM THE CITY  
OF DELAVAN.

002-2433