
ABELL SURVEYING & MAPPING

1140 SEQUOIA STREET . DELAVAN. WISCONSIN 53115 262-728-6737



NOTE: BEARINGS ARE REFERENCED TO EXISTING SURVEY RECORDS.



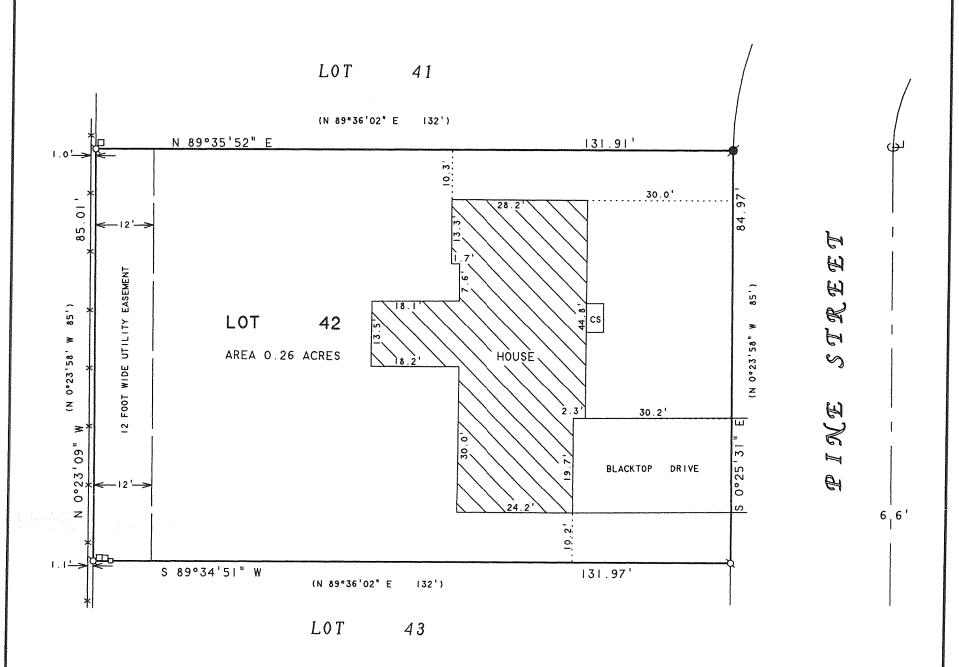


SCALE | "=20"

LEGEND

Q - IRON PIPE FOUND -IRON BAR FOUND -X -CHAINLINK FENCE

□□ -UTILITY PEDS. CS -CONCRETE STOOP

() -RECORDED AS

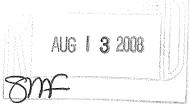

ORDERED BY: KEEFE REAL ESTATE 1155 E. GENEVA STREET DELAVAN, WI 53115

PLAT OF SURVEY OF

LOT 42. TURTLE CREEK SUBDIVISION, LOCATED IN THE CITY OF DELAVAN. WALWORTH COUNTY. WISCONSIN.

I HEREBY CERTIFY THAT I HAVE SURVEYED THE ABOVE DESCRIBED PROPERTY AND THAT THE ABOVE MAP IS A TRUE REPRESENTATION THEREOF AND SHOWS THE SIZE AND LOCATION OF THE PROPERTY, ITS EXTERIOR BOUNDARIES, THE LOCATION OF ALL VISIBLE STRUCTURES AND DIMENSIONS OF ALL PRINCIPAL BUILDINGS THEREON, BOUNDARY FENCES, APPARENT EASEMENTS, ROADWAYS AND VISIBLE ENCROACHMENTS, IF ANY, TO THE BEST OF MY KNOWLEDGE AND BELIEF. KNOWLEDGE AND BELIEF.

THIS SURVEY IS MADE FOR THE USE OF THE PRESENT OWNERS OF THE PROPERTY. AND ALSO THOSE WHO PURCHASE, MORTGAGE, OR GUARANTEE THE TITLE THERETO WITHIN ONE (I) YEAR FROM DATE HEREON.

DAVID F. ABELL WISCONSIN REGISTERED LAND SURVEYOR. 5-1596

March 27, 2008 DATE / JOB NUMBER - NOTE: THIS IS NOT A CERTIFIED COPY UNLESS SEALED. JOB NUMBER - 08007

XTC-42