


GEORGE T. DUNHAM  
SURVEYING & SUBDIVIDING  
DELAVAN, WISCONSIN

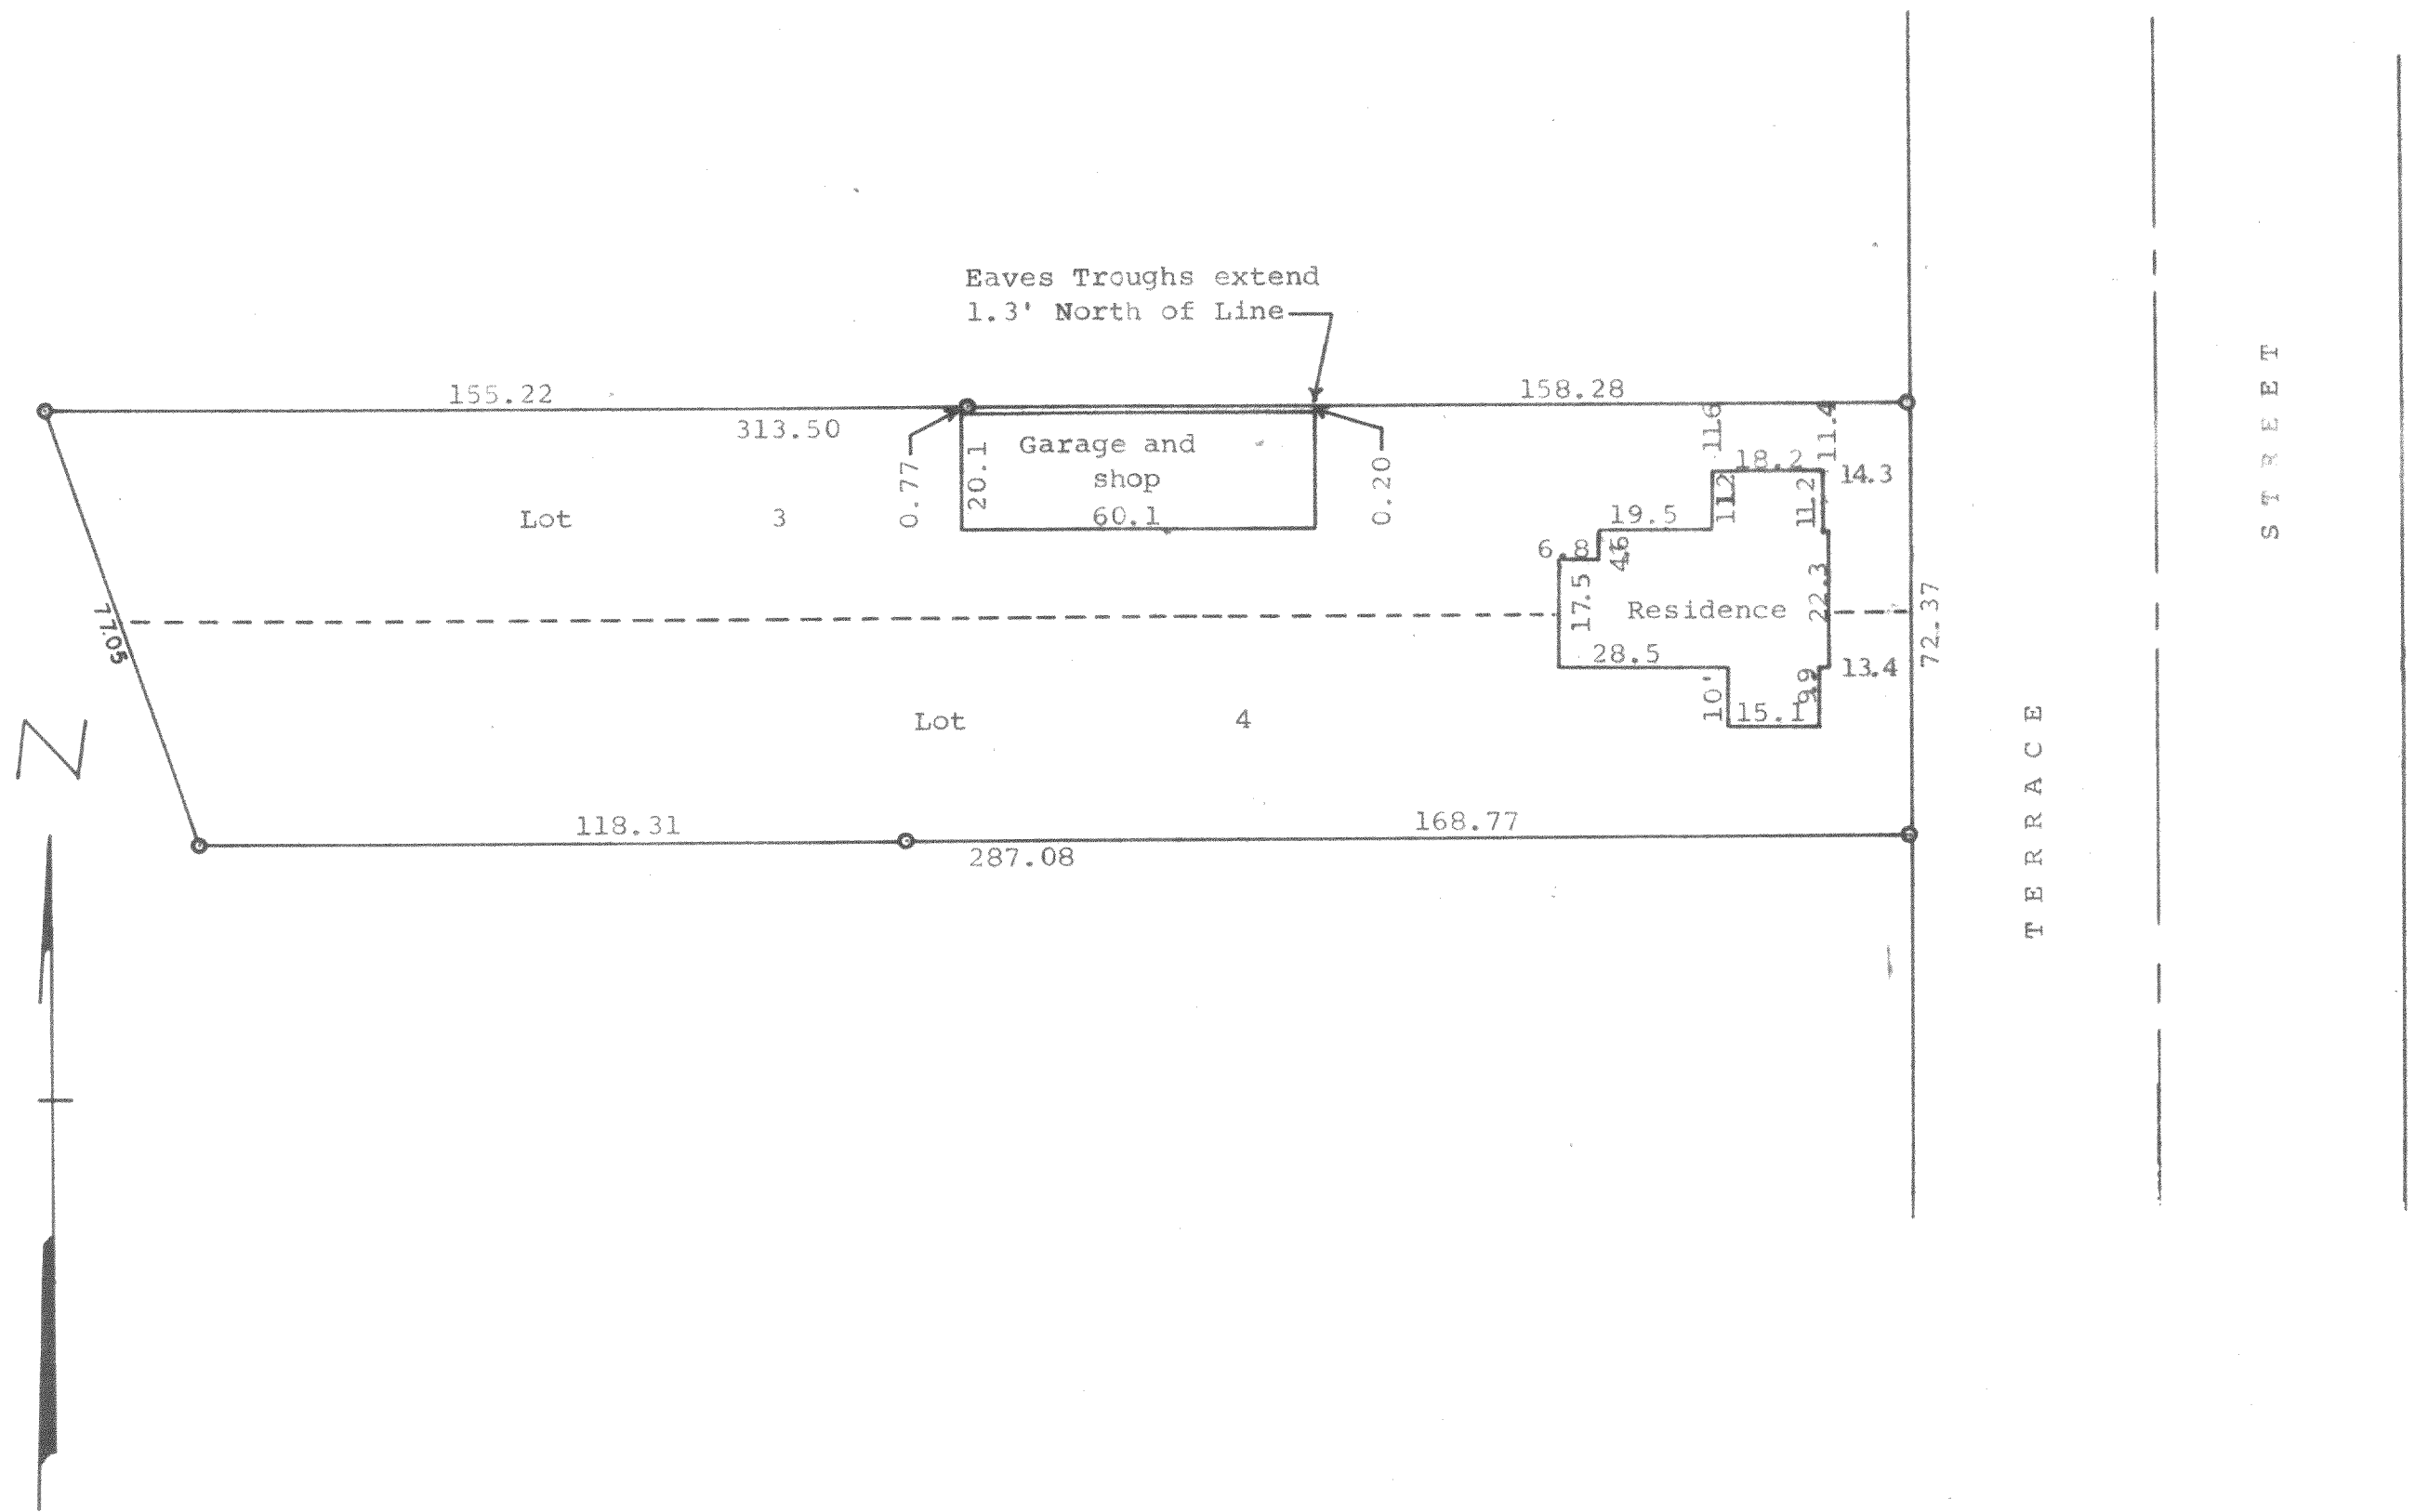

Scale - 1" = 30'  
○ = Iron Pipe

STATE OF WISCONSIN)  
WALWORTH COUNTY ) SS

I, George T. Dunham, Surveyor, do certify that  
I have surveyed the property described as follows,  
Lots 3 and 4, Block 1 of L. E. Downie's Add. to the  
City of Delavan, Walworth County, Wisconsin.  
and that the above plat is an accurate survey and a true  
representation thereof and correctly shows the exterior  
boundary lines and location of buildings on said property  
and the correct measurements thereof.  
January 11, 1966

*George T. Dunham*  
George T. Dunham, Surveyor