

1140 SEQUOIA STREET • DELAVAN, WISCONSIN 53115
262-728-6737

McDOWELL

82.50' WIDE

STREET

STREETS

82.50' WIDE

MAN

BLOCK

LOT 5

PLAT OF SURVEY OF


LOT 4 AND 6 FEET OFF THE NORTH SIDE OF
LOT 5 IN BLOCK 7 OF THE ORIGINAL PLAT
OF THE CITY OF DELAVAN, WALWORTH COUNTY,
WISCONSIN.



SCALE 1" = 30'

LEGEND

- ⊗ -IRON PIPE FOUND
- ⊗ -CONCRETE MONUMENT FOUND
- -SQUARE IRON BAR FOUND
- ⊗ -IRON ROD FOUND
- -1" DIA. IRON PIPE SET
- △ -UTILITY POLE
- -OVERHEAD UTILITY LINES
- CS -CONCRETE STOOP
- () -RECORDED AS

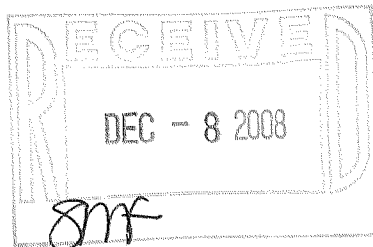

ORDERED BY: SHOREWEST REALTORS
830 E. GENEVA STREET
DELAVAN, WI 53115

I HEREBY CERTIFY THAT I HAVE SURVEYED THE ABOVE DESCRIBED PROPERTY AND THAT THE ABOVE MAP IS A TRUE REPRESENTATION THEREOF AND SHOWS THE SIZE AND LOCATION OF THE PROPERTY, ITS EXTERIOR BOUNDARIES, THE LOCATION OF ALL VISIBLE STRUCTURES AND DIMENSIONS OF ALL PRINCIPAL BUILDINGS THEREON, BOUNDARY FENCES, APPARENT EASEMENTS, ROADWAYS AND VISIBLE ENCROACHMENTS, IF ANY, TO THE BEST OF MY KNOWLEDGE AND BELIEF.

THIS SURVEY IS MADE FOR THE USE OF THE PRESENT OWNERS OF THE PROPERTY, AND ALSO THOSE WHO PURCHASE, MORTGAGE, OR GUARANTEE THE TITLE THERETO WITHIN ONE (1) YEAR FROM ~~DATE~~ HEREON.

DAVID F. ABELL
WISCONSIN REGISTERED LAND SURVEYOR. S-1596

August 19, 2008

DATE 7/25/81 JOB NUMBER - 93178A
NOTE: THIS IS NOT A CERTIFIED COPY UNLESS SEALED.

XOP-31

002-2454