
DUNHAM SURVEYING, S.C. SURVEYING & SUBDIVIDING DELAVAN, WISCONSIN 53115

BIRCHWOOD

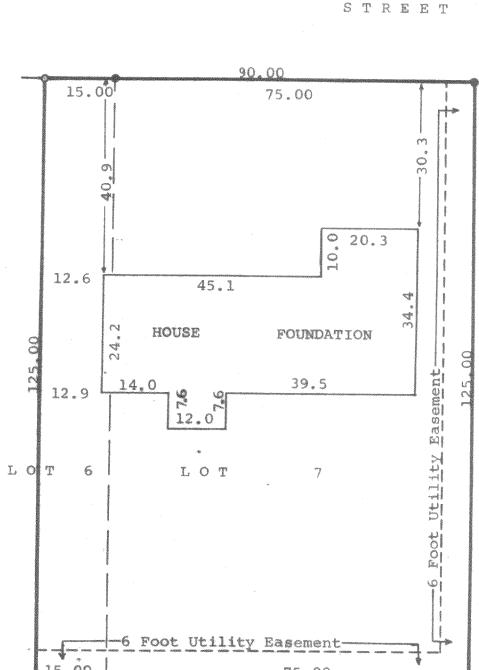

90.00

Scale - 1" = 20' • = Iron Rod Found • = Iron Pipe Set ø = Iron Pipe Found

> STATE OF WISCONSIN) SS COUNTY OF WALMORTH)

I, James M. Dunham, Surveyor, certify that I have surveyed the property described as follows,

Lot 7 and the East 15.00 feet of Lot 6, Turtle Creek Subdivision, located in the Southwest & of the Southeast & of Section 13,

T 2 N, R 15 E, City of Delavan, Walworth County, Wisconsin, and the above map is a true representation thereof and shows the size and location of the property, its exterior boundaries, the location and dimensions of all structures thereon, fences, apparent easements and roadways and visible encroachments, if any. This survey is made for the exclusive use of the present owners of

the property, and also those who purchase, mortgage, or guarantee the title thereto within one (1) year from date hereof; and as to them I warrant the accuracy of said survey and map. October 9, 1978

James M. Dunham, Surveyor

DELAVAN, MAN SURVEY