

LAND-MARK SURVEYING

Mark L. Miritz

Wisconsin Registered Land Surveyor S-2582


N9330 Knuteson Drive
Whitewater, WI 53190
Phone: (262) 495-3284
FAX: (262) 495-8421
LAND-MARKSURVEYING.COM

PLAT OF SURVEY

LOT 13, BLOCK 3, PASSAGE, ARAM AND DOWNIE'S ADDITION
TO THE VILLAGE (NOW CITY) OF DELAVAN, WALWORTH
COUNTY, WISCONSIN.

OWNER: MANUEL A. JARAMILLO
321 S. FOURTH STREET
DELAVAN, WI 53115

THE EAST LINE OF FOURTH ST.
WAS ASSUMED TO BEAR NORTH

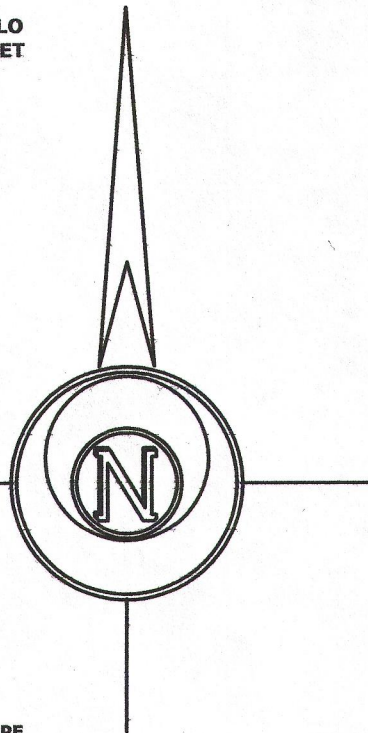

LEGEND

- FOUND IRON PIPE
- FOUND IRON ROD
- FOUND P.K. NAIL
- SET IRON ROD, 18" LONG, WEIGHING 1.5 LBS./LINEAL FT., 3/4" DIA.
- RECORDED AS DIMENSION
- EXISTING FENCE

SCALE: 1 INCH = 20 FEET


"I hereby certify that the above described property has been surveyed by me or under my direction and that the above map is a true representation thereof and shows the size and location of the property, its exterior boundaries, the location of all visible structures and dimensions of all principal buildings thereon, boundary fences, apparent easements, roadways and visible encroachments, if any."
"This survey is made for the use of the present owners of the property, and also those who purchase, mortgage, or guarantee the title thereto within one year from date hereof."

MARK L. MIRITZ
WISCONSIN REGISTERED
LAND SURVEYOR S-2582

DATE: APRIL 30, 2013 JOB NO. 13.405



FOURTH STREET
(82.5' WIDE)

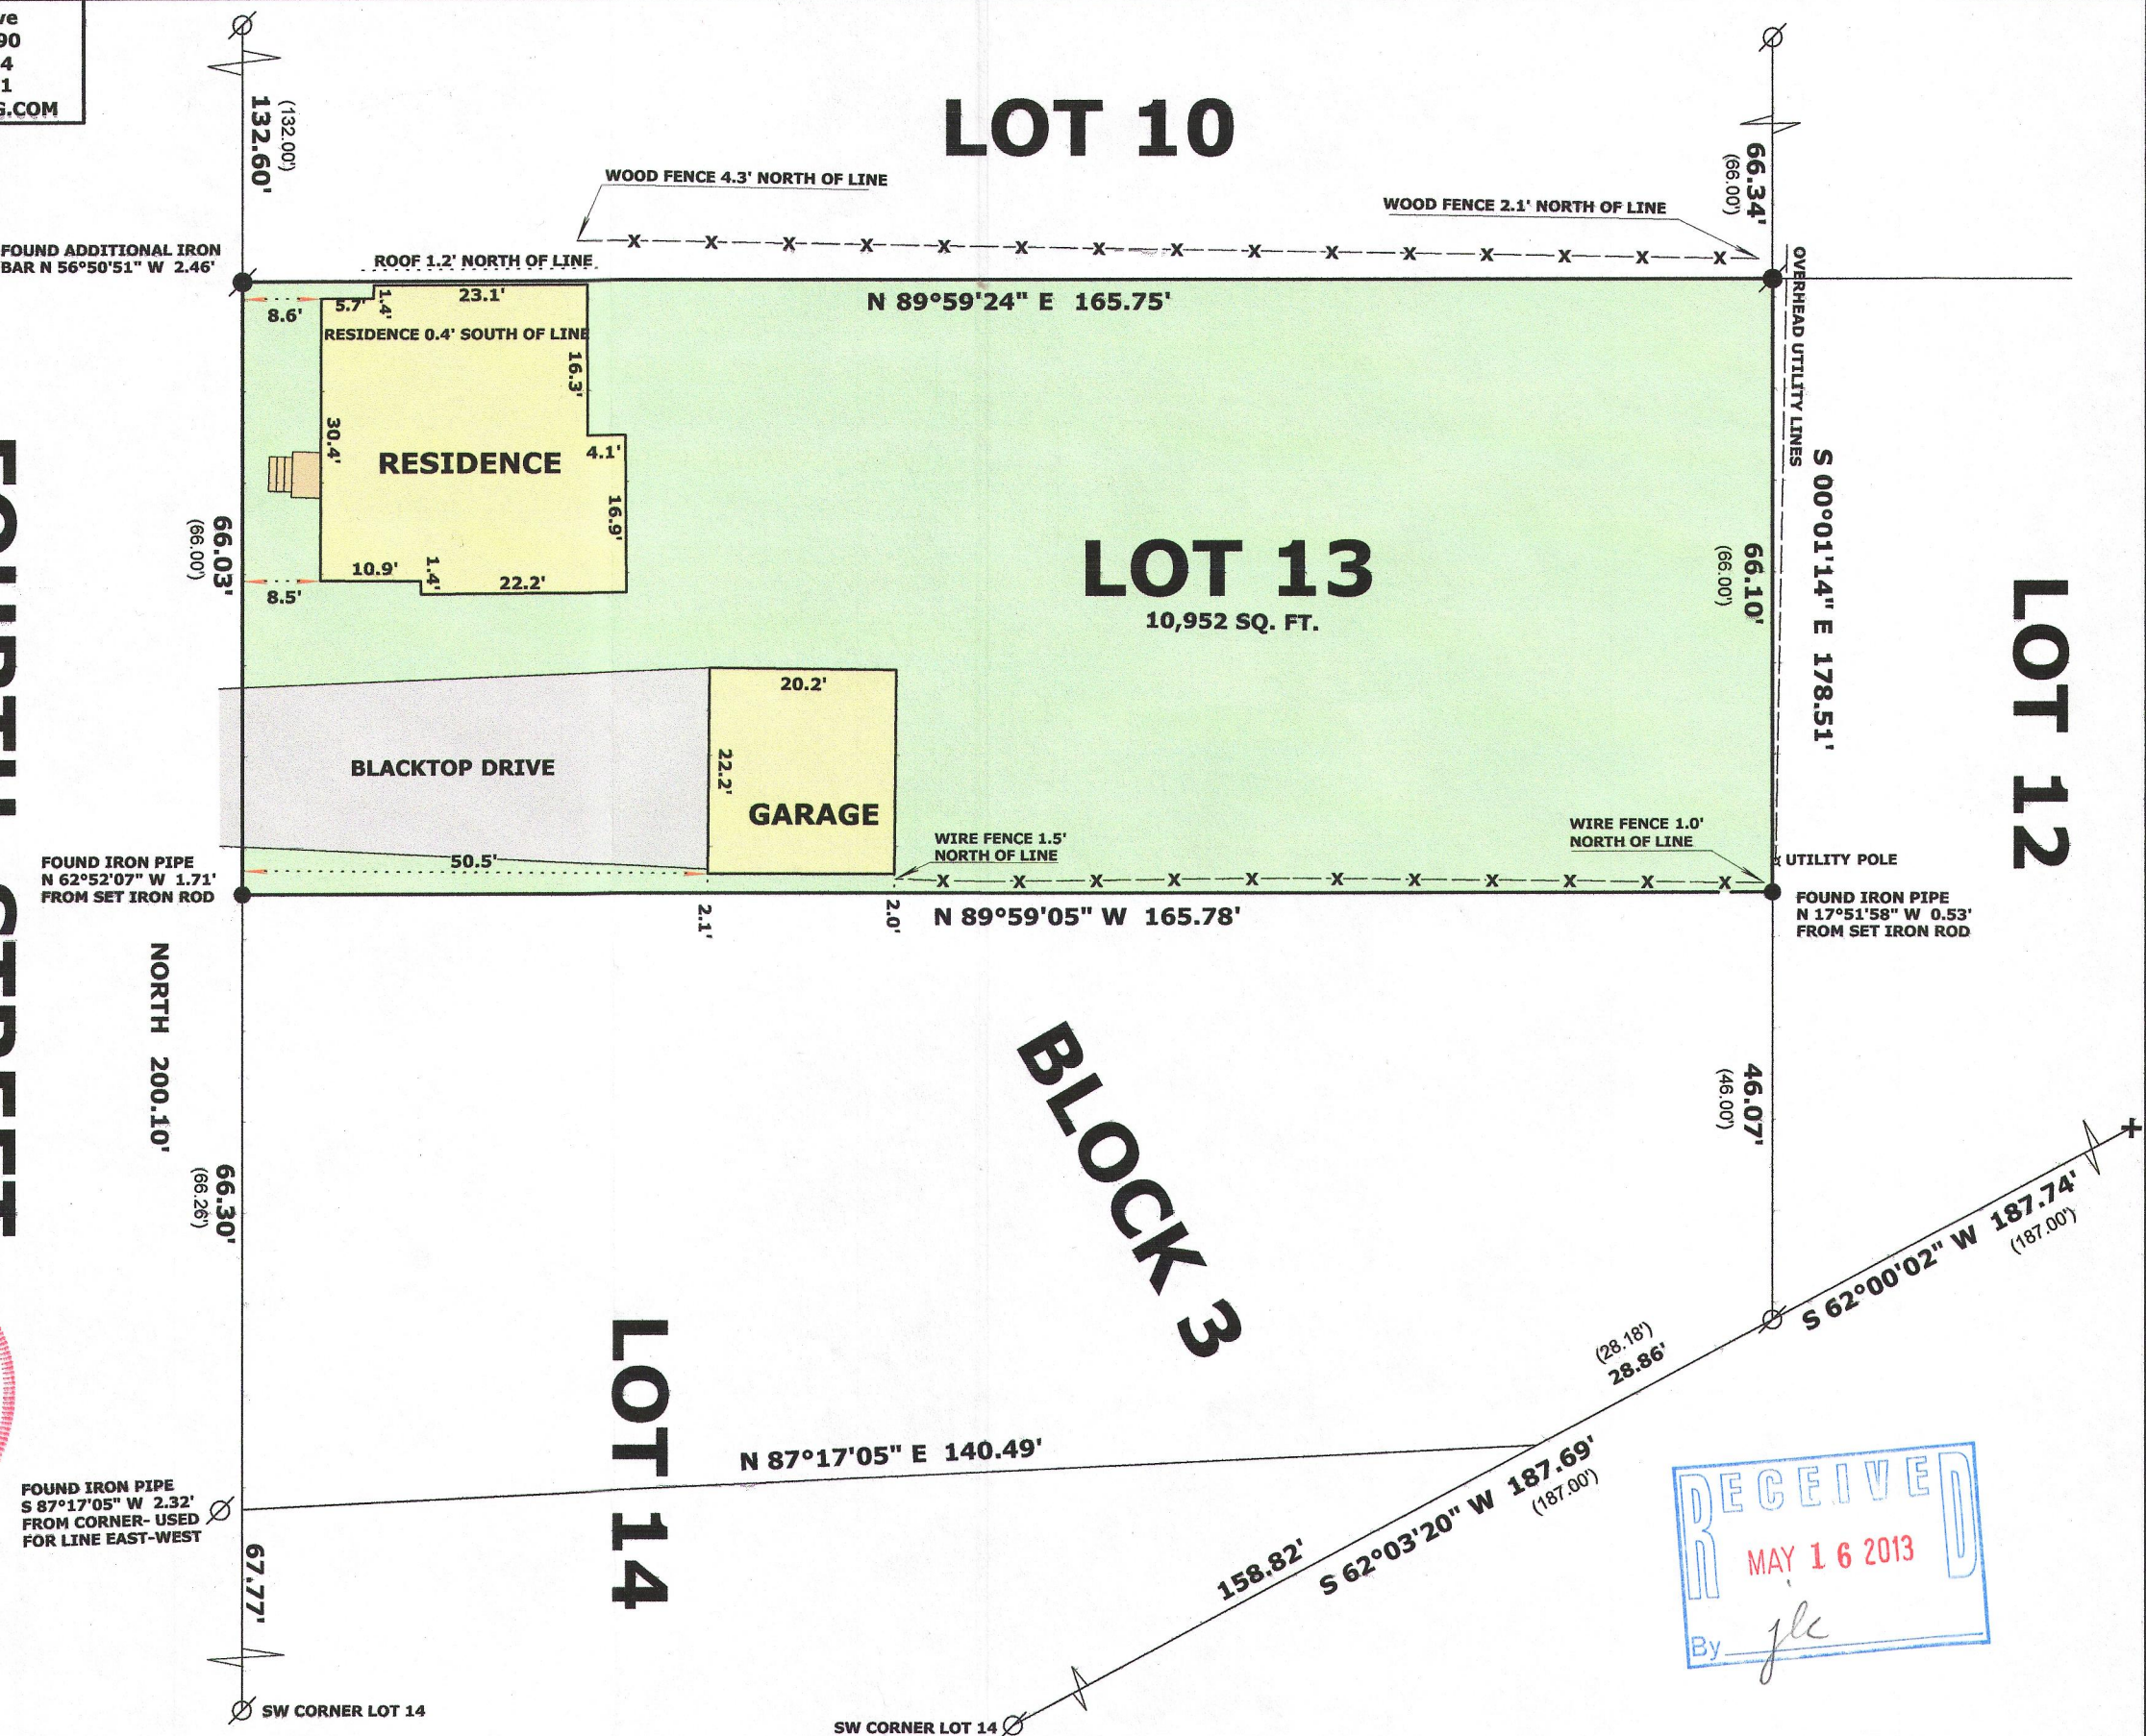

XP 00040 002-2531