


# Plat of Survey

of


## Lot 2 of Knapp's Subdivision,

located in the Southeast 1/4 of Section 18 and the Northeast 1/4 of Section 19,  
Town 2 North, Range 16 East, City of Delavan, Walworth County, Wisconsin.

Surveyed for: **Matt Vavra**  
435 Phoenix Street  
Delavan, Wisconsin. 53115

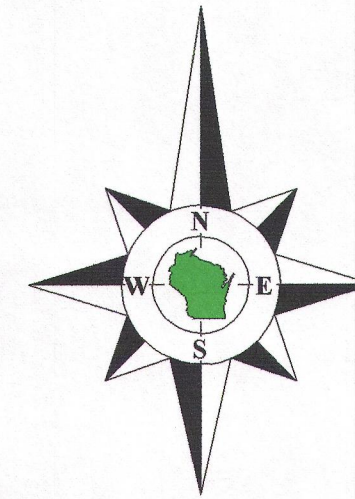

Bearings reference to the plat  
of Knapp's Subdivision.

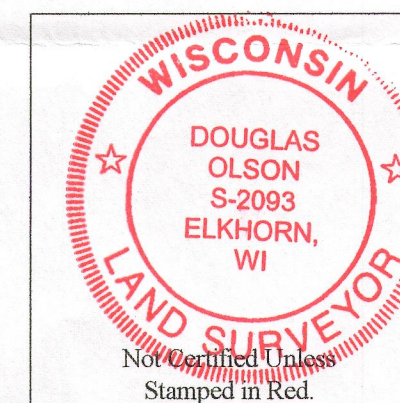

### Notes:

- 1) This survey plat is not certified unless signed and sealed in red ink.
- 2) This survey is subject to Wisconsin lien laws. This Plat of Survey is the notice of intent to file lien. Lien waiver required.
- 3) Additional iron pipes at corners are 1-1/4" dia. and set in concrete and appear to be chain link fence corner posts which have been cut off.

Copyright 2013 by Jensen & Olson Land Surveying, LLC.

All rights reserved. No part of this survey plat may be reproduced or transmitted in any form by any means - graphic, electronic, or mechanical, including photocopying, tracing, or information storage and retrieval systems - without permission in writing from Douglas G. Olson, Jensen & Olson Land Surveying, LLC.

I, Douglas G. Olson, Wisconsin Registered Land Surveyor, do hereby certify that this survey was performed by me, or under my direction in full compliance with the owner's/agent's instructions and Chapter A-E 7 of the Wisconsin Administrative Code "Minimum Standards for Property Surveys"; and that this map is an accurate representation thereof to the best of my knowledge and belief.

Douglas G. Olson  
Wisconsin Registered Land Surveyor - 2093

Survey Date: June 28, 2013.  
Revisions: No. 1 - Misc.

Scale in Feet  
1" = 20'  
0' 10' 20' 40'

**Jensen & Olson Land Surveying, LLC**

45 South Wisconsin Street \* P.O. Box 322 \* Elkhorn, Wisconsin. 53121  
Telephone: (262) 723-3434 \* Facsimile: (262) 723-8044  
Email: jensen.olson@elknet.net

**Legend**  
Found County Section Corner  
Found Concrete Monument  
Found Iron Pipe, 1" dia.  
Set Iron Pipe, 1" dia.  
Recorded Information  
Utility Pole  
Manhole  
Asphalt Surface  
Concrete  
Fire Hydrant  
Water Valve

Sheet 1 of 1 Sheets  
Drawing Name: Chrt16c-2013053-2013053Plat.dwg  
Job Reference Number  
**2013.053**

2013.053

002-2538