
PLAT OF SURVEY -OF-

LOT 6 EXCEPTING A STRIP OF LAND 21 FEET IN WIDTH OFF THE EAST SIDE THEREOF, ALSO ALL OF LOTS 7 AND 8, ALL IN BLOCK 13 OF THE ORIGINAL PLAT OF THE VILLAGE (NOW CITY) OF DELAVAN, ACCORDING TO THE PLAT THEREOF. SAID LAND BEING IN THE CITY OF DELAVAN, WALWORTH COUNTY, WISCONSIN.

SURVEY FOR: CHRISTOPHER PHILLIPS OF SHOREWEST REALTORS SURVEY ADDRESSES: 110, 114, 116 AND 118 EAST WALWORTH AVENUE, DELAVAN, WI 53115

-EAST-----WALWORTH-----AVENUE-----

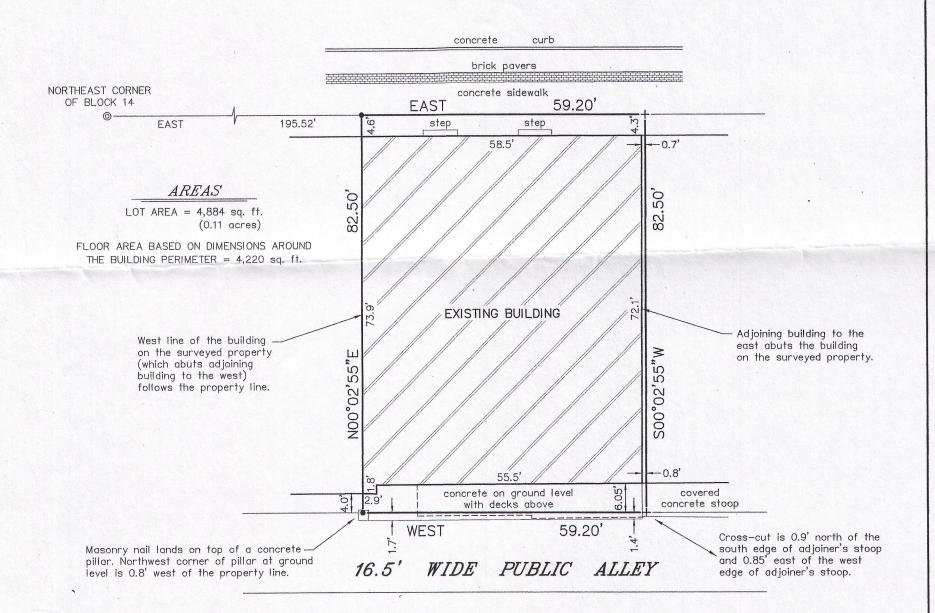

LEGEND


- © FOUND CONCRETE MONUMENT (AXLEROD IN CONCRETE)
- FOUND MASONRY NAIL
- + FOUND CHISELED CROSS-CUT

"I HEREBY CERTIFY THAT I HAVE SURVEYED THE ABOVE DESCRIBED PROPERTY AND THAT THE ABOVE MAP IS A CORRECT REPRESENTATION THEREOF AND SHOWS THE SIZE AND LOCATION OF THE PROPERTY, ITS EXTERIOR BOUNDARIES, THE LOCATION OF ALL VISIBLE STRUCTURES AND DIMENSIONS OF ALL PRINCIPAL BUILDINGS THEREON, BOUNDARY FENCES, APPARENT EASEMENTS, ROADWAYS AND ENCROACHMENTS, IF ANY."

"THIS SURVEY IS MADE FOR THE USE OF THE PRESENT OWNERS OF THE PROPERTY, AND THOSE WHO PURCHASE, MORTGAGE, OR GUARANTEE THE TITLE THERETO WITHIN ONE YEAR FROM DATE HEREOF"

SATTER SURVEYING, LLC LAND SURVEYS, MAPPING AND PLANNING

272 ORIGEN STREET BURLINGTON, WI 53105 262-661-4239

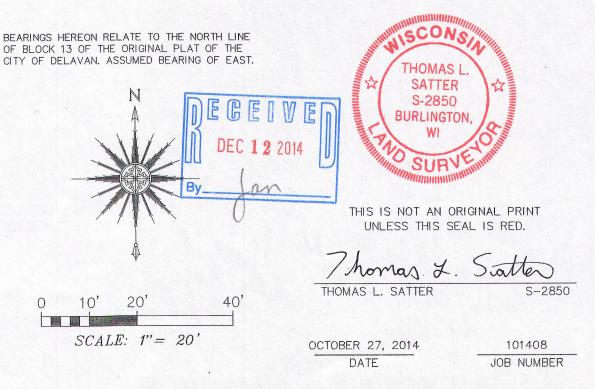

XOP-127 002

002-2564