PREPARE FOR: MARY KILKENNY KEEFE REAL ESTATE DELAVAN, WI.

## PLAT OF SURVEY

- OF -

PATHFINDER SURVEYING INC.

(formerly)

J.K. SURVEYING INC.


P.O BOX 322

LAKE GENEVA, WI. 53147

WWW.PATHFINDERSURVEYING.NET
50F. 262-248-8303

LOT 3 IN HILLTOP SUBDIVISION, ACCORDING TO THE RECORD PLAT THEREOF. SAID LAND BEING IN THE CITY OF DELAVAN, COUNTY OF WALWORTH AND STATE OF WISCONSIN, LOCATED IN THE NW 1/4 OF THE SW 1/4 OF SECTION 18, TOWN 2 NORTH, RANGE 16 EAST, CITY OF DELAVAN, COUNTY OF WALWORTH AND STATE OF WISCONSIN.

## SCHAUF STREET

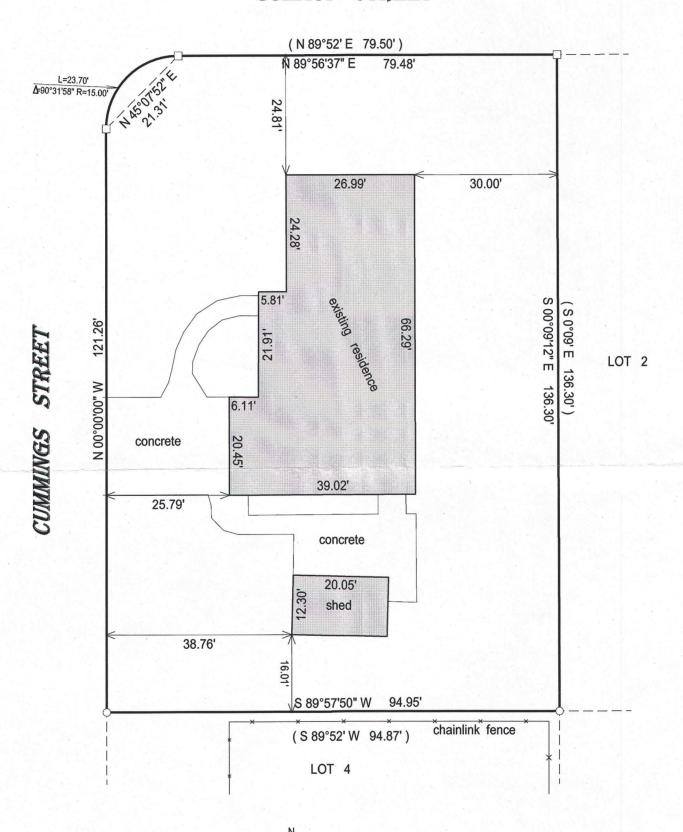

( )= recorded as

□ = found iron bar

= found iron pipe

= set iron pipe

= set iron bar

SCALE 1" = 20'

JOB # 15-206

TAX ID # XHI00003





BASIS OF BEARING OF THIS PLAT: THE EAST LINE OF CUMMINGS WAS ASSUMED TO BEAR NORTH.

I hereby certify that I have surveyed the above- described property and the above map is a is a true representation thereof and shows the size and location of the property, its exterior boundaries, the location and dimensions of all structures thereon, fences, apparant easements and roadways and visible encroachments if any.

This survey is made for the present owners of the property, and those who purchase, mortgage, or guarantee the title thereto, within one year from the date hereof.

DATED THIS 30TH DAY OF JUNE, 2015.

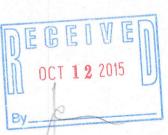

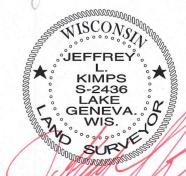

JEFFREY L KIMPS S - 2436 Wisconsin Professional Land Surveyor (original if signed in red)