




PREPARE FOR:
 MARY KILKENNY
 KEEFE REAL ESTATE
 DELAVAN, WI.

PLAT OF SURVEY


- OF -

PATHFINDER SURVEYING INC.
 (formerly)
 J.K. SURVEYING INC.
 P.O BOX 322
 LAKE GENEVA, WI. 53147
 WWW.PATHFINDERSURVEYING.NET
 262-248-8303

LOTT 6, BLOCK 14 IN ALLYNHURST ADDITION No. 3, A SUBDIVISION OF OUTLOT 1, BLOCK 14 AND OUTLOT 1, BLOCK 15 IN ALLYNHURST ADDITION No. 2, LOCATED IN THE NE 1/4 OF THE NW 1/4 OF SECTION 20, TOWN 2 NORTH, RANGE 16 EAST, IN THE CITY OF DELAVAN, COUNTY OF WALWORTH AND STATE OF WISCONSIN.

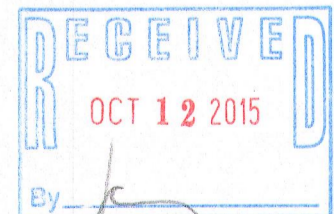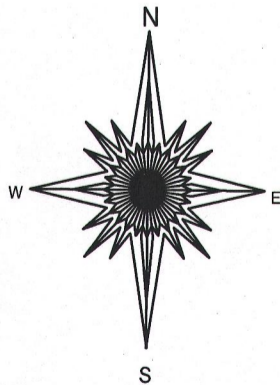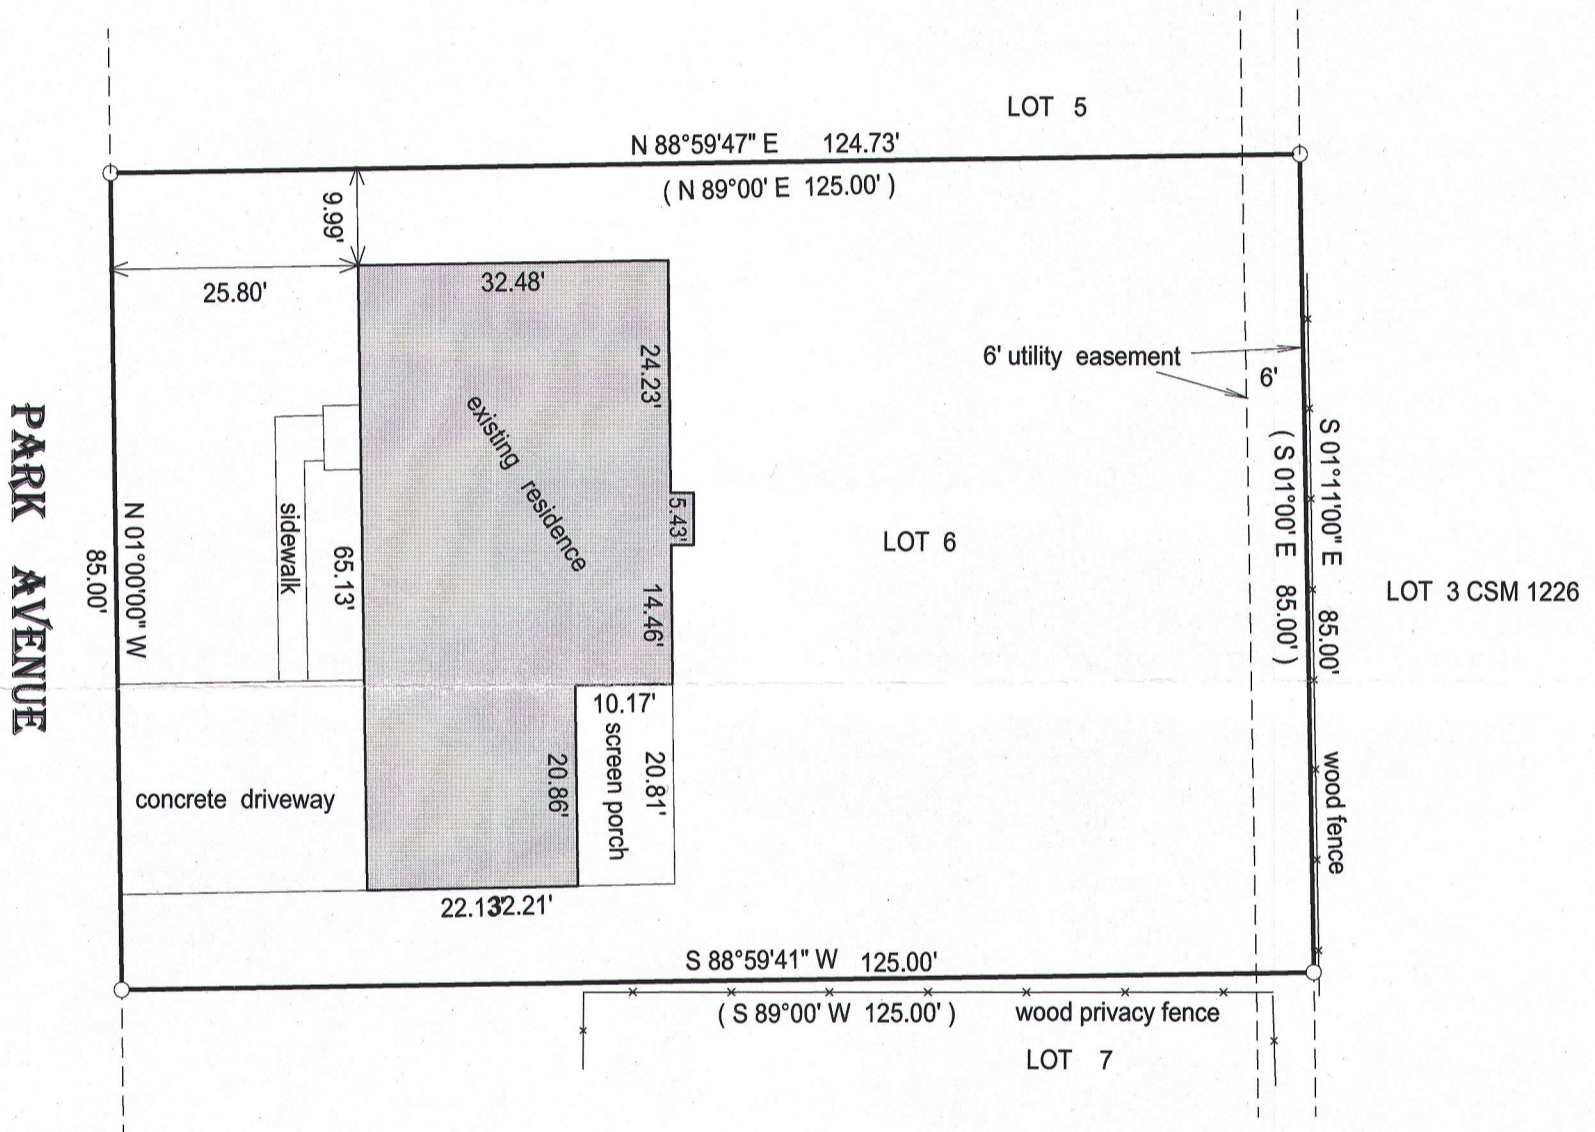

- () = recorded as
- = found iron bar
- = found iron pipe
- = set iron pipe
- = set iron bar

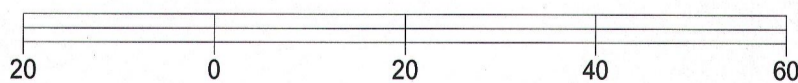

BASIS OF BEARING OF THIS PLAT: THE EAST LINE OF PARK AVENUE WAS ASSUMED TO BEAR N 01°00' W AS SHOWN ON THE RECORD PLAT.


I hereby certify that I have surveyed the above- described property and the above map is a true representation thereof and shows the size and location of the property, its exterior boundaries, the location and dimensions of all structures thereon, fences, apparrant easements and roadways and visible encroachments if any.

This survey is made for the present owners of the property, and those who purchase, mortgage, or guarantee the title thereto, within one year from the date hereof.

SCALE 1" = 20'

JOB # 15-221

TAX ID # XAS30002

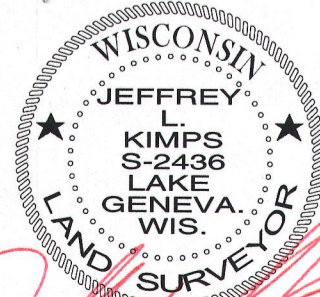

JEFFREY L. KIMPS S-2436
 Wisconsin Professional Land Surveyor
 (original if signed in red)

DATED THIS 9TH DAY OF JULY, 2015.