PREPARED FOR KEN CARLSON SHOREWEST REALTY 830 E. GENEVA ST DELAVAN, WI. 53115


## PLAT OF SURVEY

 
- OF -

PATHFINDER SURVEYING INC. (formerly) J.K. SURVEYINĞ INC. P.O BOX 322 LAKE GENEVA, WI. 53147 WWW.PATHFINDERSURVEYING.NET 262-248-8303

LOT 5, BLOCK 6 IN SPRING PARK SUBDIVISION, ACCORDING TO THE RECORD PLAT THEREOF. SAID LAND BEING IN THE CITY OF DELAVAN, COUNTY OF WALWORTH AND STATE OF WISCONSIN.

## GENEVA STREET

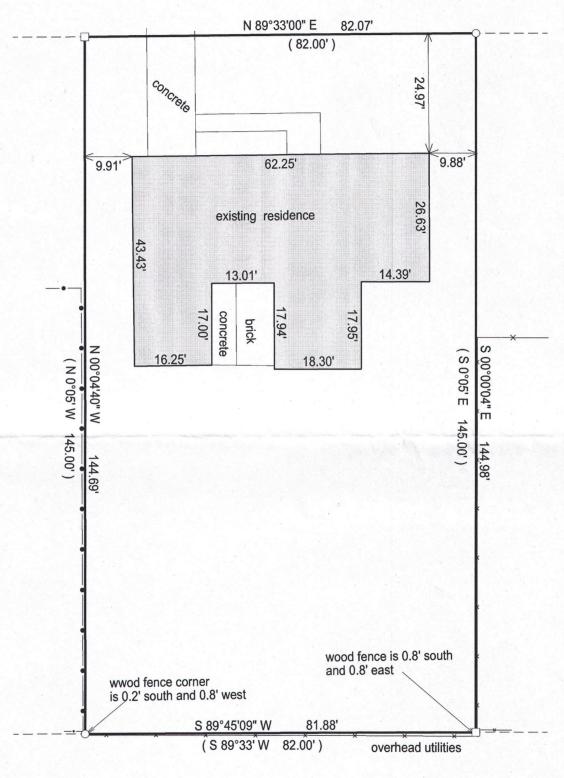




- = found iron bar
- = found iron pipe
- = set iron pipe
- = set iron bar

SCALE 1" = 20'

JOB # 16-162

TAX ID # XSPS 00031

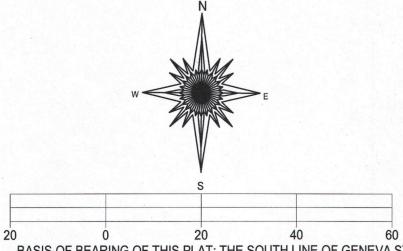

BASIS OF BEARING OF THIS PLAT: THE SOUTH LINE OF GENEVA ST WAS ASSUMED TO BEAR N 89°33' E AS MONUMENTED.

I hereby certify that I have surveyed the above- described property and the above map is a is a true representation thereof and shows the size and location of the property, its exterior boundaries, the location and dimensions of all structures thereon, fences, apparant easements and roadways and visible encroachments if any.

This survey is made for the present owners of the property, and those who purchase, mortgage, or guarantee the title thereto, within one year from the date hereof.

DATED THIS 8TH DAY OF JUNE, 2016.



JEFFREY L KIMPS \$-2436 Wisconsin Professional Land Surveyor

(original if signed in red)