Plat of Survey A parcel of land described in a Document recorded April 13, 2015 as Document No. 902532 as Lot 3 in Block 2, of J.B. Devendorf's Addition to the Village, now City, of Delavan, and all of Lot 4 in said Block 2 of said J.B. Devendorf's Addition, except a strip of land off the south side of said Lot 4 deeded to the City of Delavan, and excepting from the above described real estate the east 80 feet thereof as more particularly described in warranty deed to Clyde W. Blakelee and Inez J. Blakelee, as recorded in Volume 338 of Deeds on page 293, Walworth County Records. Surveyed for: Shorewest Realtors 830 East Geneva Street Delavan, Wisconsin. 53115 DEC 14 2017 8MC Bearings referenced to the West line of Eighth Street from Parish Street to Racine Street, recorded as North on prior surveys of record.

Copyright ©2017 by Olson Land Surveying, LLC.

All rights reserved. No part of this survey plat may be reproduced or transmitted in any form by any means - graphic, electronic, or mechanical, including photocopying, tracing, or information storage and retrieval systems - without permission in writing from Douglas G. Olson, Olson Land Surveying, LLC.

I hereby certify that I have surveyed the above described property in compliance with Chapter A-E 7 of the Wisconsin Administrative Code and that the map hereon is correct to the best of my professional knowledge and belief and shows the size and location of the property, its exterior boundaries, the location and dimensions of all visible structures thereon, boundary fences, apparent easements and roadways and visible encroachments, if any.

This survey is made for the exclusive use of the present owners of the property, and also those who purchase, mortgage of guarantee title thereto, within one year from

the date hereof. Douglas G. Olson

Wisconsin Professional Land Surveyor - 2093

(66') **66**.15'

N89°56'47"W 464.25'

(21.8') 21.76'


10.90'

(148.5') 148.53 DOUGLAS OLSON ELWIJRN, WI SUR Not Certified Unless

Stamped in Red.

Notes:

- 1) This Plat of Survey is not certified unless signed and sealed in red ink.
- 2) This survey is subject to Wisconsin lien laws. This Plat of Survey is the notice of intent to file lien. Lien waiver required.
- 3) The Survey Date shown on this Plat of Survey is the completion date of the field work.

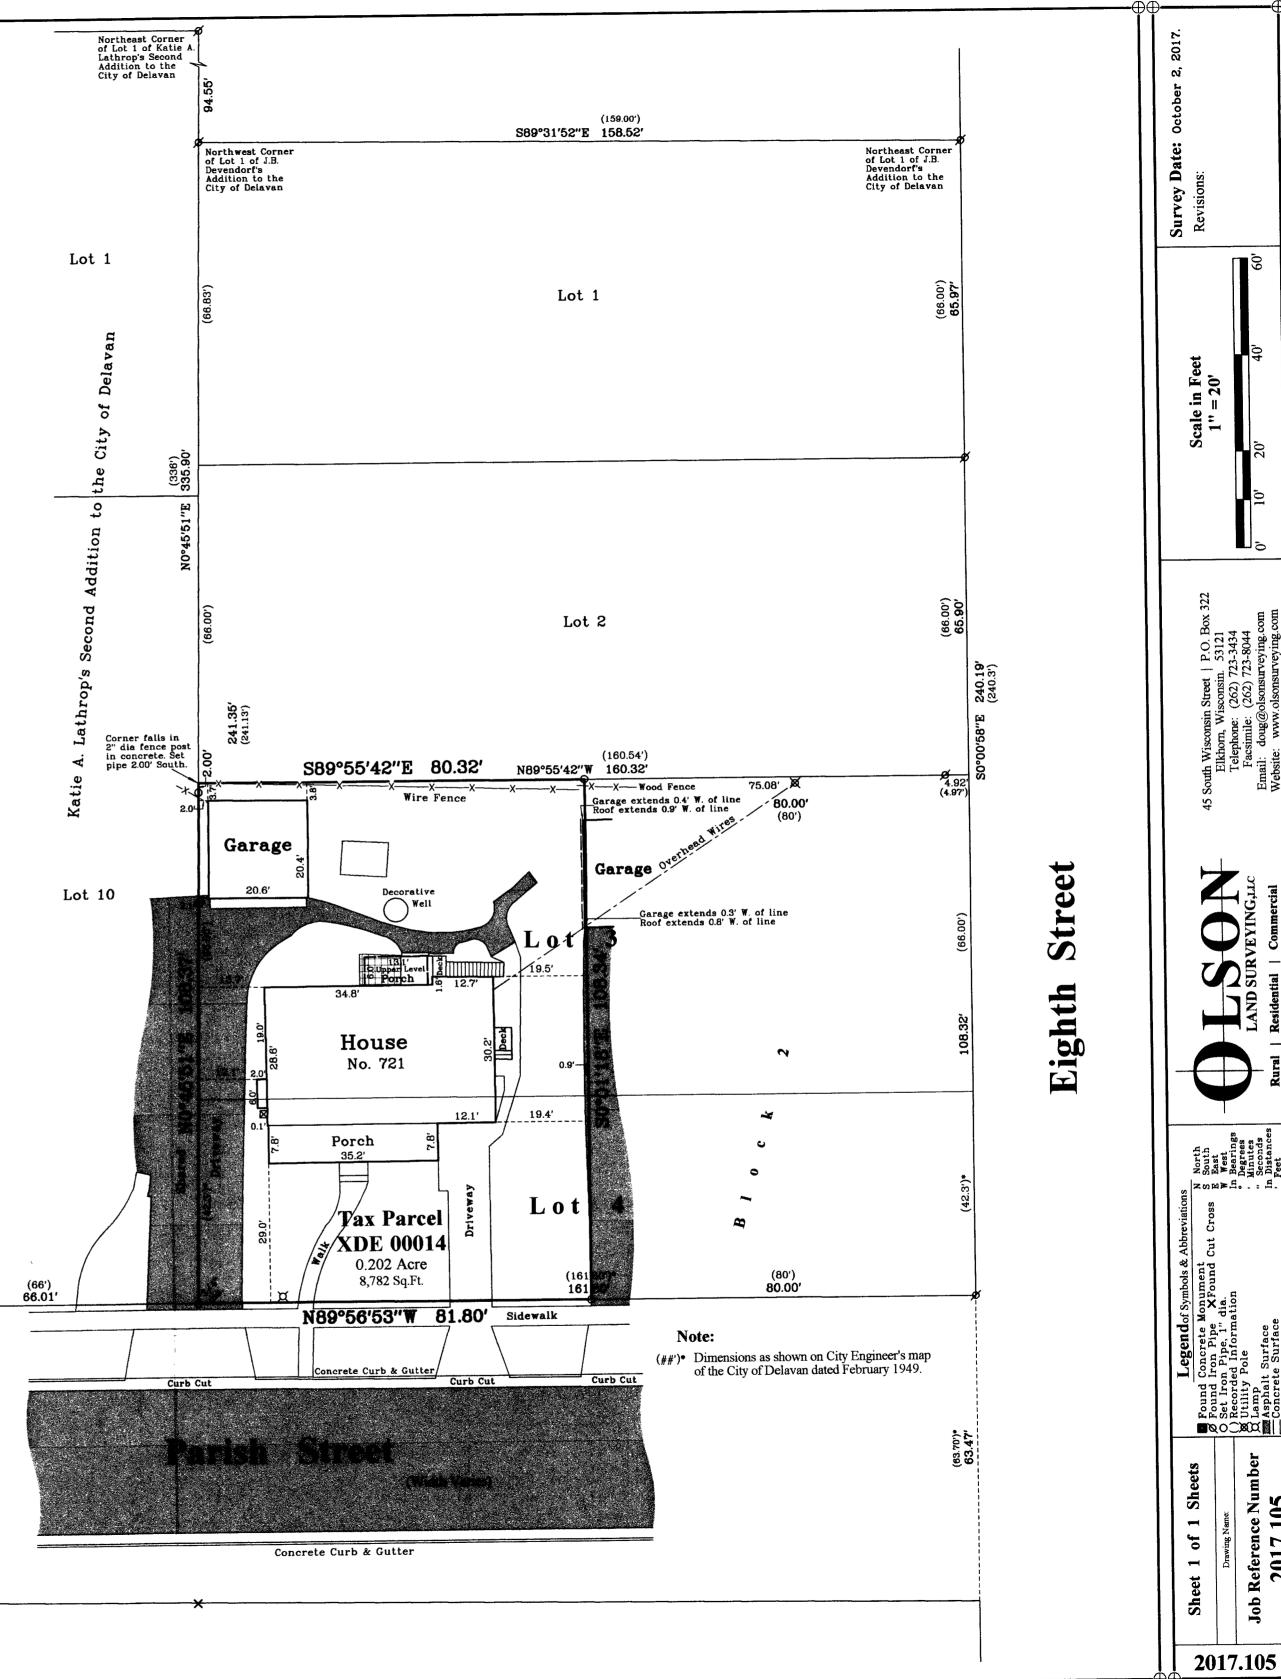

VNE - III

002-2631

Reference Nun 2017.105