


PLAT OF SURVEY

TAMARACK ST.

(66' WIDE)

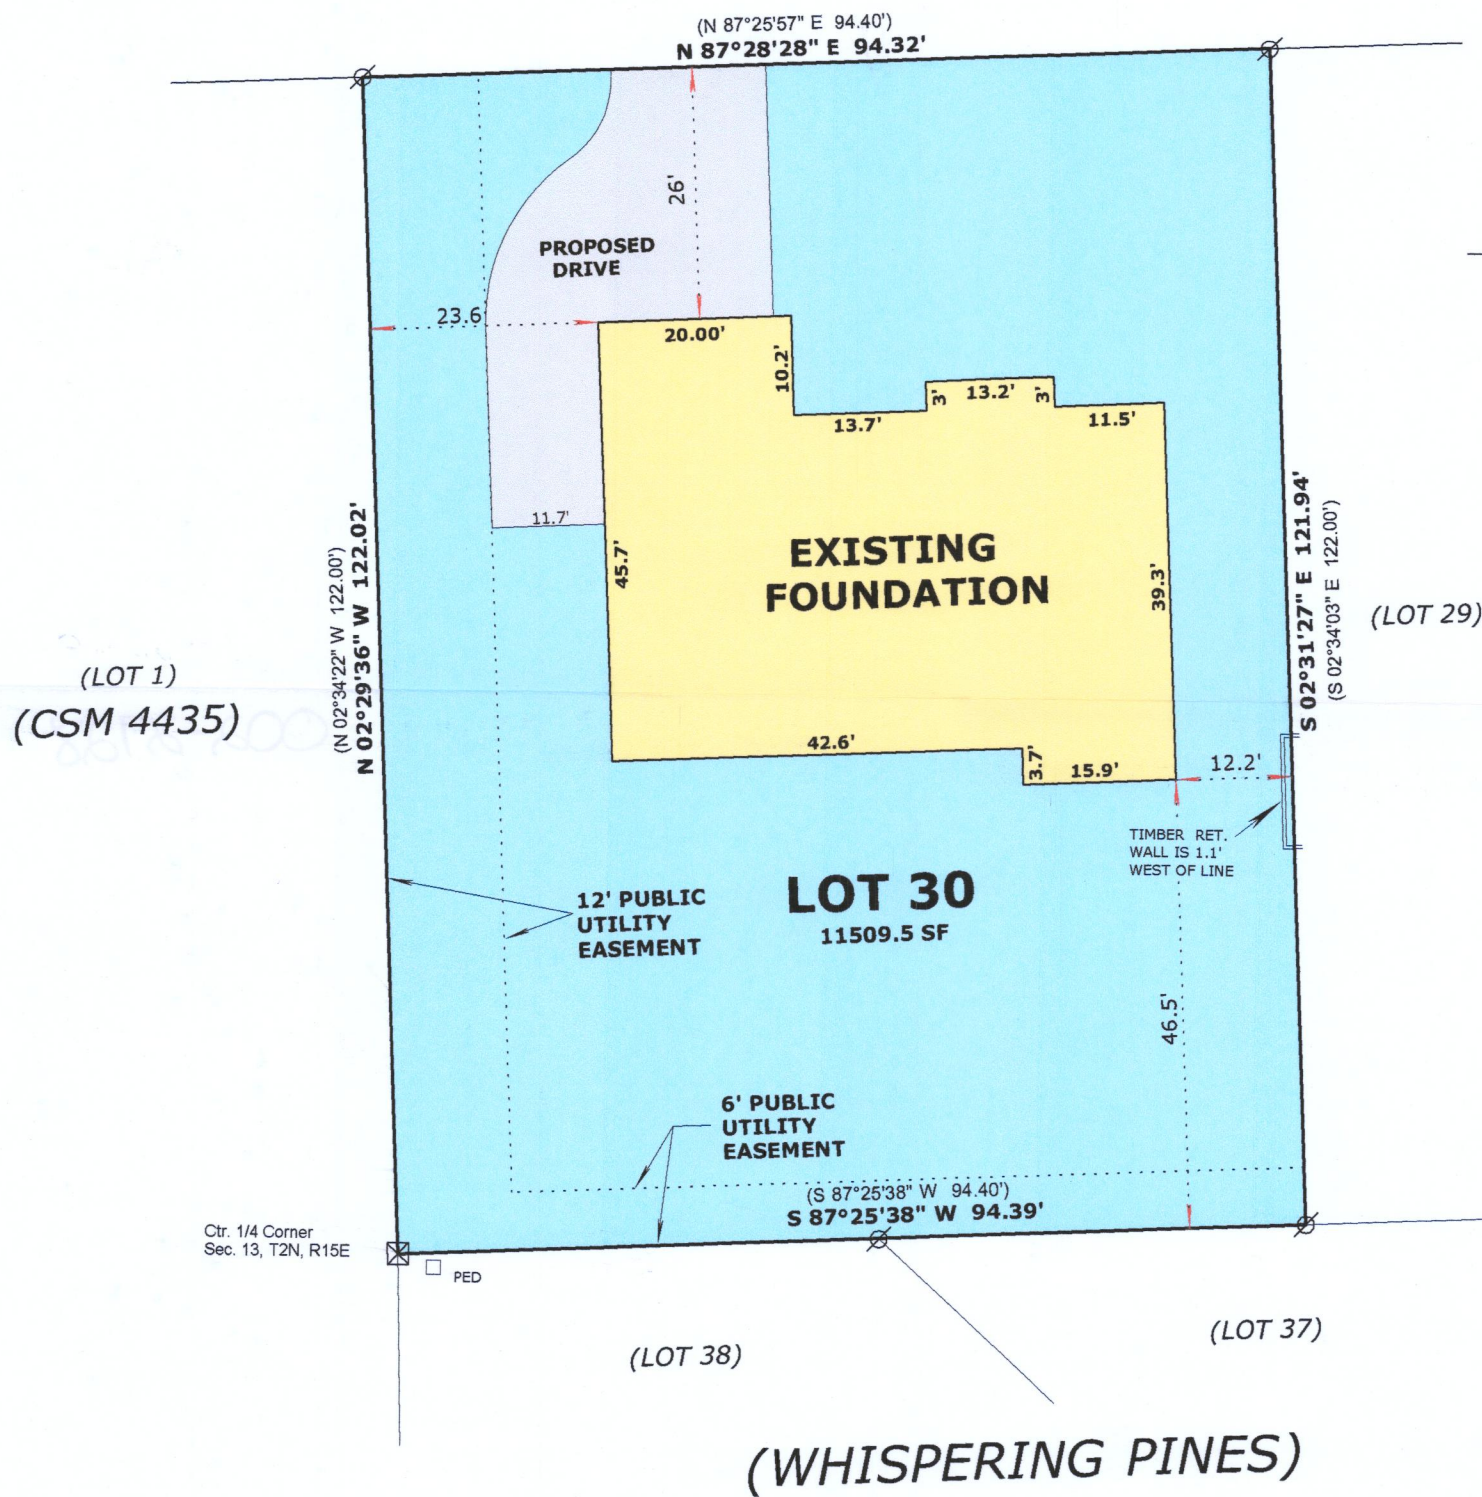

LEGEND

- Ø FOUND IRON PIPE
- ⊠ FOUND COUNTY MONUMENT
- (x x) RECORDED AS DIMENSION

SCALE: 1 INCH = 20 FEET

"I hereby certify that the above described property has been surveyed by me or under my direction and that the above map is a true representation thereof and shows the size and location of the property, its exterior boundaries, the location of all visible structures and dimensions of all principal buildings thereon, boundary fences, apparent easements, roadways and visible encroachments, if any." "This survey is made for the use of the present owners of the property, and also those who purchase, mortgage, or guarantee the title thereto within one year from date hereof."

Mark L. Miritz
MARK L. MIRITZ

WISCONSIN PROFESSIONAL
LAND SURVEYOR S-2582

DATE: January 25, 2021 JOB NO. 21.104

LEGAL DESCRIPTION:

LOCATED IN THE SOUTHWEST 1/4 OF THE NORTHEAST 1/4, SECTION 13
TOWNSHIP 2 NORTH, RANGE 15 EAST, IN THE CITY OF DELAVAN,
WALWORTH COUNTY, WISCONSIN.

LOT 30, GLEN OAKS OF DELEVAN



ORDERED BY:
Basso Builders Inc.
405 Skyline Dr.
Lake Geneva, WI 53147

REVISED APRIL 13, 2021 TO SHOW FOUNDATION "AS BUILT"
2/09/21 Adjust House for 12' (min) Sideyard (East Side)