PLAT OF SURVEY

OF LOT 20, WHISPERING PINES, BEING PART OF THE NW 1/4 OF THE SE 1/4 OF SECTION 13, T. 2 N., R. 15 E., OF THE 4TH P.M., CITY OF DELAVAN, WALWORTH COUNTY, WISCONSIN.

MONUMENT KEY

3/4" Iron Rebar Found 1" Iron Pipe Found

X Cut Cross Set (XXX,XX)Record Information U.E. **Utility Easement**

KRISTIN J.
BELONGIA
S-2943
ELKHORN
WIS.

LEGEND

 \otimes

0

Existing Boundary Line Existing Right-of-Way Existing Adjacent Property **Existing Easement Line** Existing Fence Existing Telephone Pedestal

> Existing Water Valve Existing Fire Hydrant

Existing Round Inlet

Existing Electric Box

Kristin J. Belongia, P.L.S. Wisconsin Professional Land Surveyor S-2943

State of Wisconsin County of Rock


If the surveyor's signature is not red in color, the plan is a copy that should be assumed to contain unauthorized alterations The certification contained on this document

shall not apply to any copies.

I hereby certify that I have supervised the survey of the property described above and to the best my knowledge and belief, the plat drawn hereon complies with Chapter A-E 7 of the State of Wisconsin Administrative Code, Minimum Standards for Property Surveys and correctly represents the size and location of the property, exterior boundaries, the location of all visible structures, and dimensions of all principle buildings thereon, fences, easements of record, and roadways, if any. This survey is made for the use of the present owners of the property, and also those who purchase, mortgage, or guarantee the title thereto within one year from the date

Given under my hand and seal this 6th day of August, 2020 at Beloit, Wisconsin Last day of field work August 6th, 2020

Revised this 28th day of July, 2021 to show location of residence and of adjusted fence.

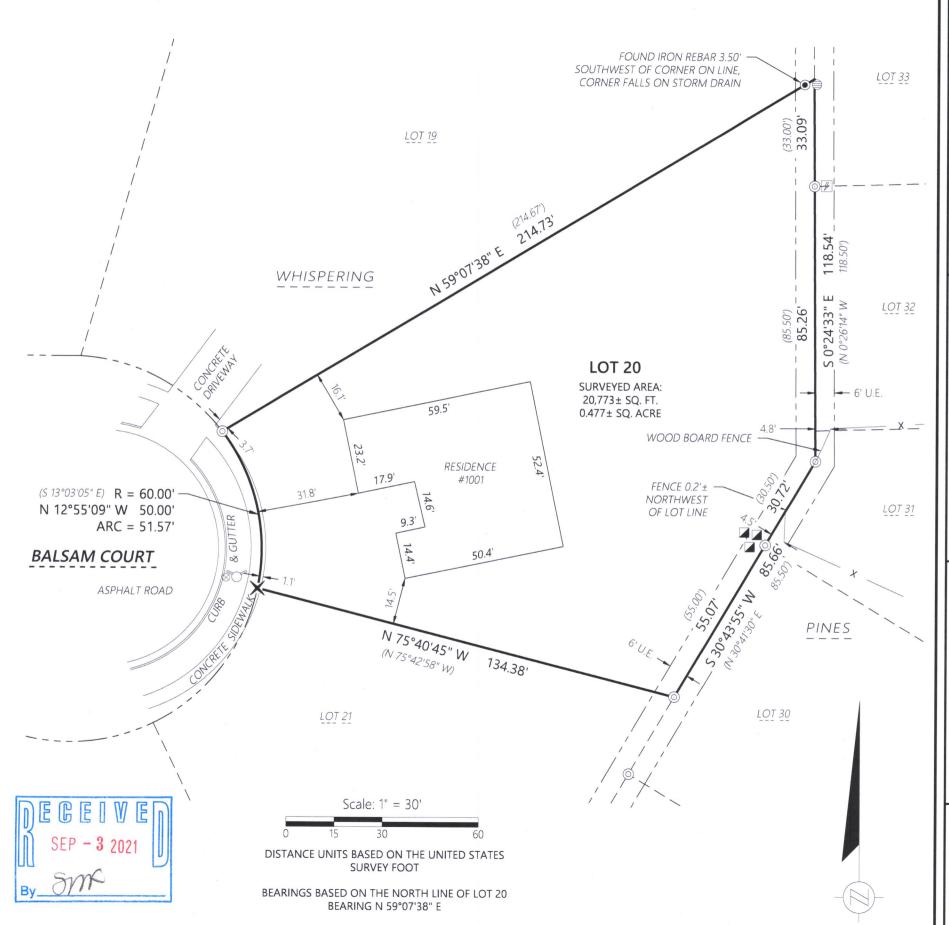



Batterman

SURVEY OF

PLAT

Allan Ansorge PO Box 566 Delavan, WI 53115

field crew; dje Drawn by; dje

ORDER NO: 33679