


LAKELAND SURVEYORS LLC  
P O BOX 188  
DEHAVAN, WI 53115  
262-475-9567  
email: lakelandsurveyors@outlook.com

PLAT OF SURVEY

OF  
LOT 3, CERTIFIED SURVEY MAP NO. 33, LOCATED IN THE  
CITY OF DELAVAN, WALWORTH COUNTY, WISCONSIN.

FRANKLIN STREET 66'

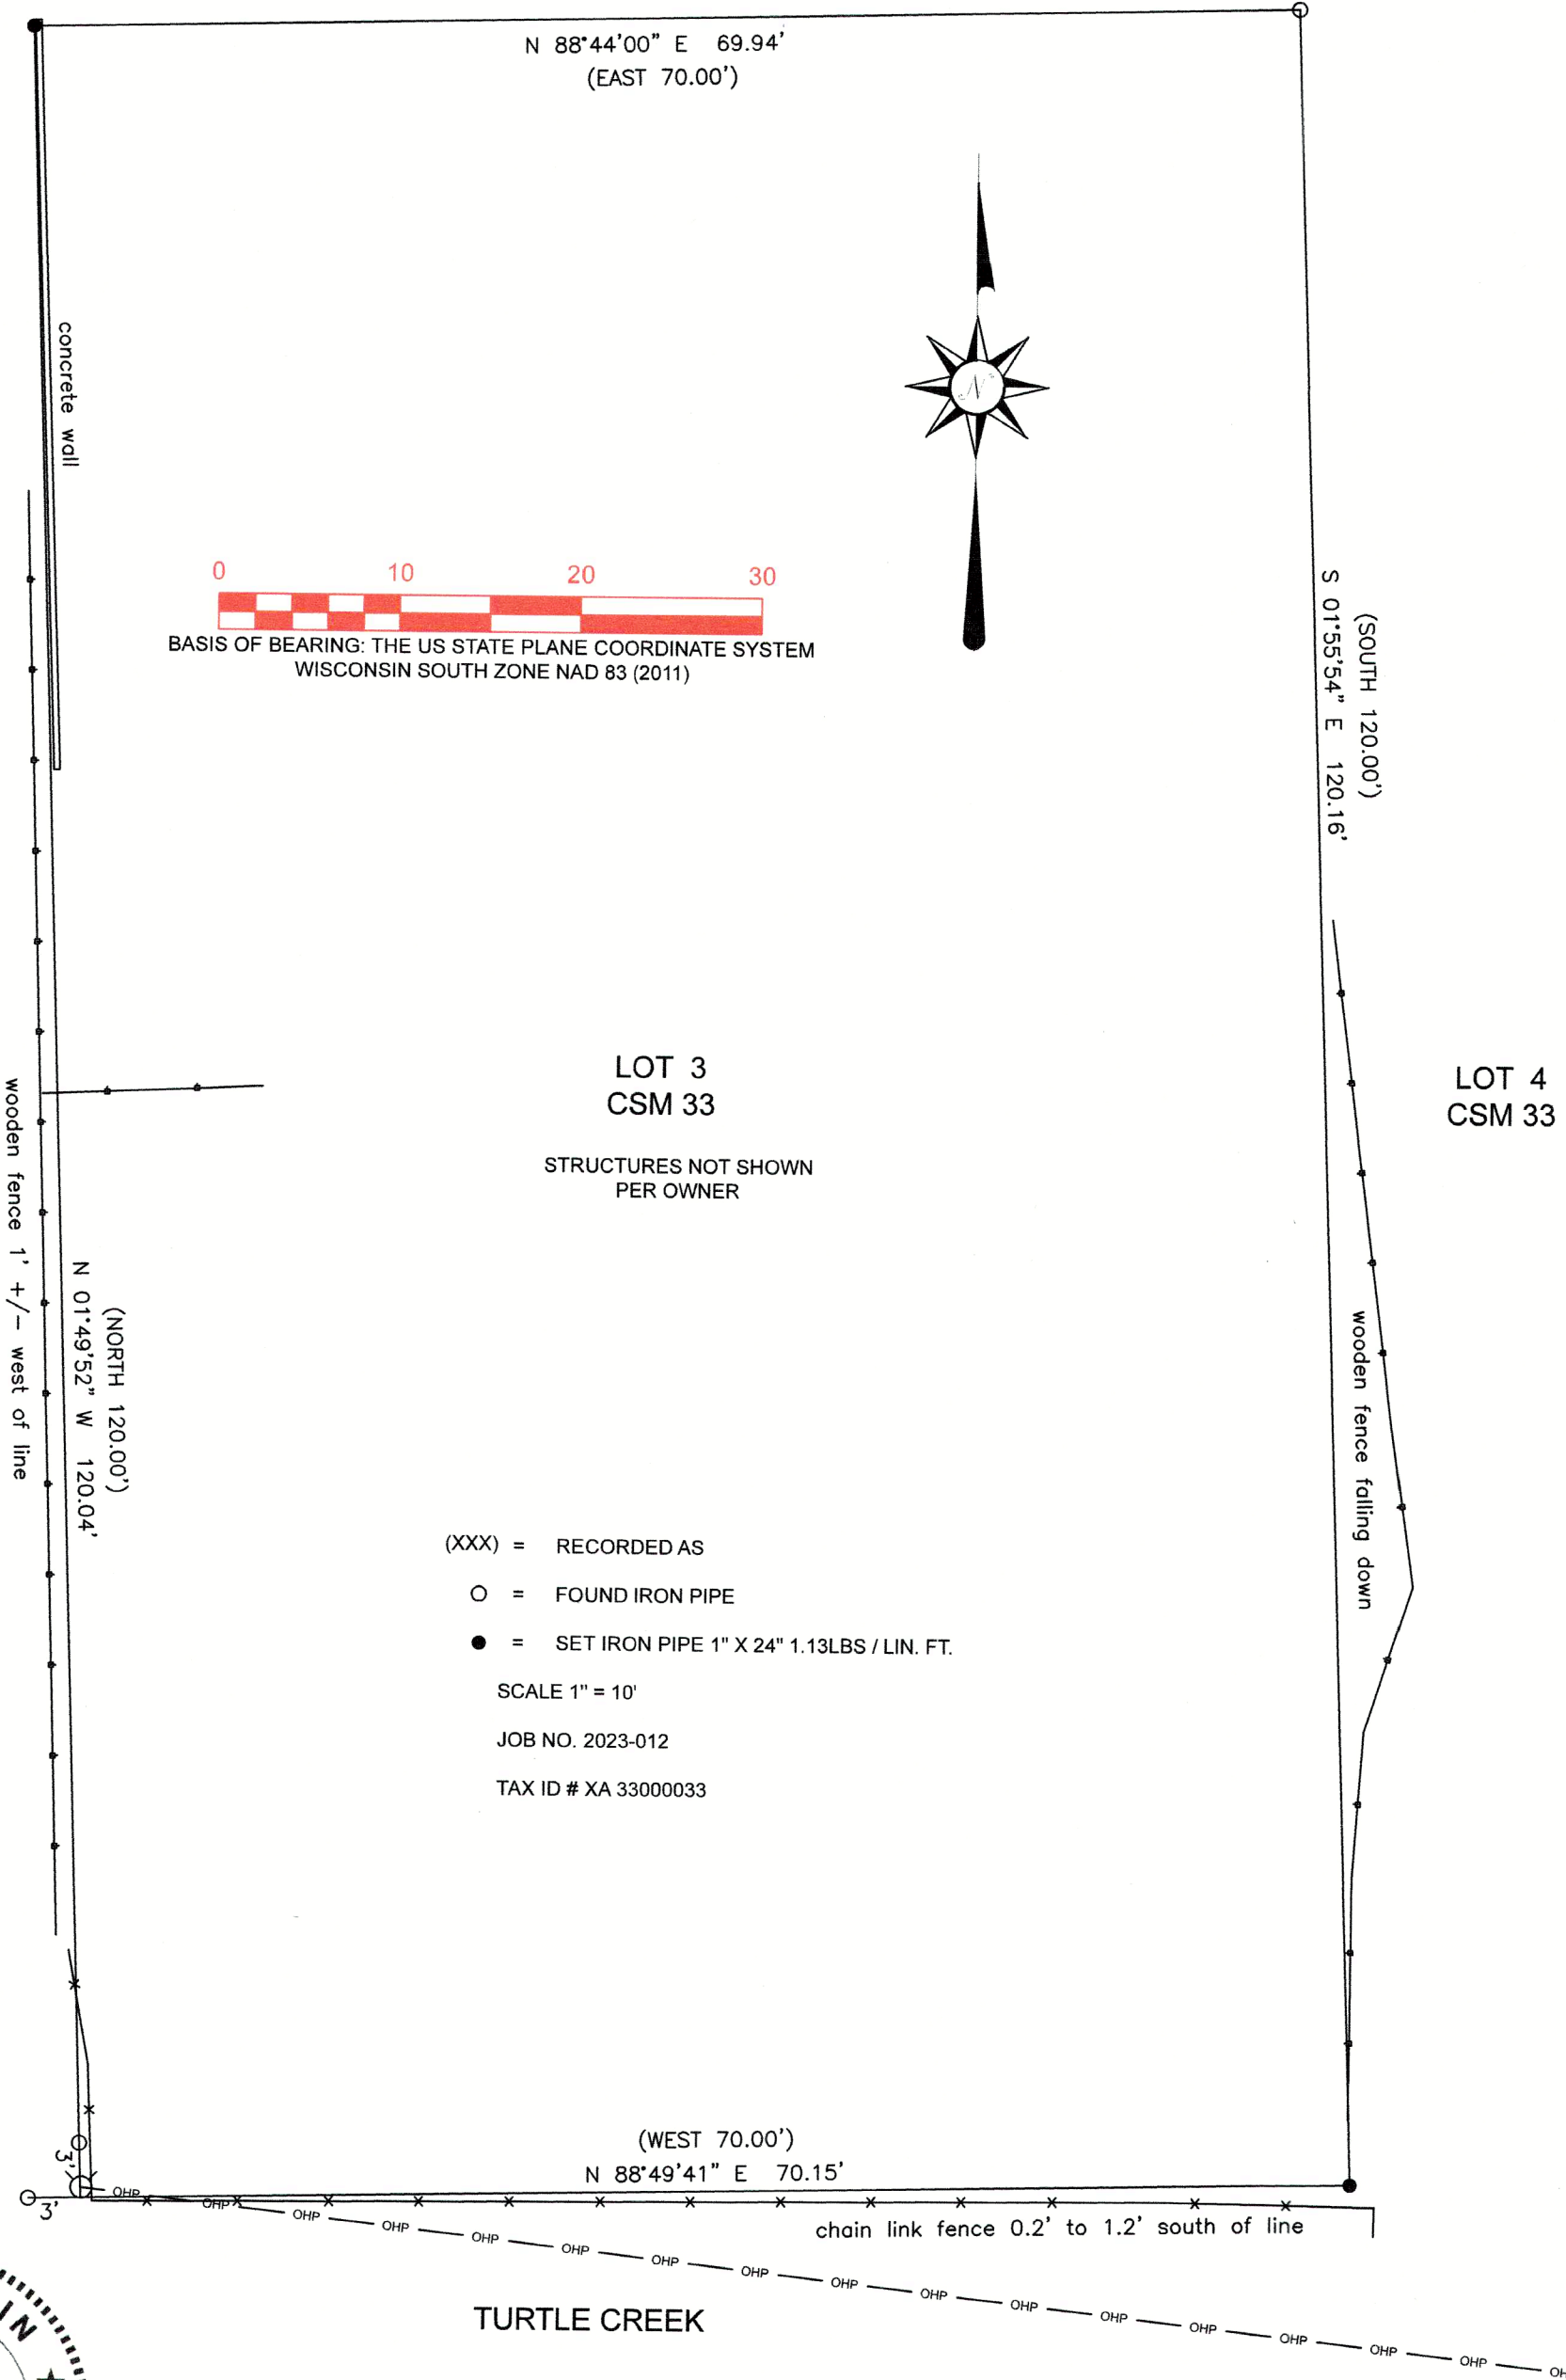

(XXX) = RECORDED AS  
O = FOUND IRON PIPE  
● = SET IRON PIPE 1" X 24" 1.13LBS / LIN. FT.  
SCALE 1" = 10'  
JOB NO. 2023-012  
TAX ID # XA 33000033

RECEIVED  
MAY 23 2023  
By *SMF*



*Steven L. Schmidt*

STEVEN L. SCHMIDT S - 2813  
Wisconsin Professional Land Surveyor

PREPARED FOR:  
DEANNE FURSETH

I HEREBY CERTIFY THAT I HAVE SURVEYED THE ABOVE DESCRIBED PROPERTY AND THE ABOVE MAP IS A TRUE REPRESENTATION THEREOF AND SHOWS THE SIZE AND LOCATION OF THE PROPERTY, ITS EXTERIOR BOUNDARIES, THE LOCATION AND DIMENSIONS OF ALL STRUCTURES THEREON, FENCES, APPARENT EASEMENTS, ROADWAYS, AND VISIBLE ENCROACHMENTS, IF ANY.

THIS SURVEY IS MADE FOR THE PRESENT OWNERS OF THE PROPERTY AND THOSE WHO PURCHASE, MORTGAGE, OR GUARANTEE THE TITLE THERETO WITHIN ONE YEAR FROM THIS DATE HEREOF.

DATED THIS 4TH DAY OF MAY 2023

XA 33000033

002-2772