
## GEORGE T. DUNHAM SURVEYING & SUBDIVIDING DELAVAN, WISCONSIN

WALWORTH

AVENUE

Northwest Corner of Lot 2, Block 11 Original Plat of the Village, (Now City) of Delavan

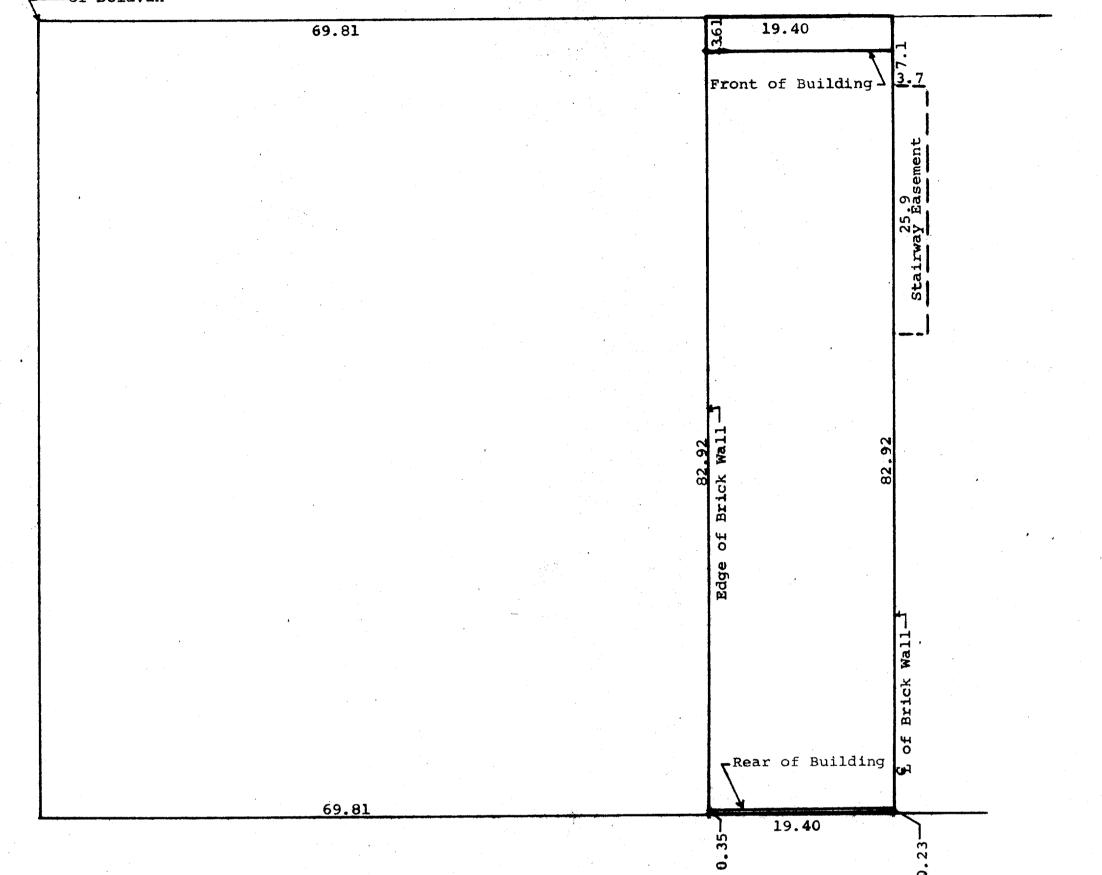

Scale - 1" = 10'

ALLEY

STATE OF WISCONSIN) SS WALWORTH COUNTY WALWORTH COUNTY

I, George T. Dunham, Surveyor, do hereby certify that

I have surveyed the property described as follows, A parcel of land located in Lots 1 and 2, Block 11 of the Original Plat of the Village of Delavan, Walworth County, Wisconsin described as follows, to-wit: Beginning on the north line of said Lot 2 at a point located 69.81 feet East of the northwest corner of said Lot 2; thence South parallel with the west line of said Block 82.92 feet to the north line of an alley; thence East parallel with the north line of said Block 11, 19.40 feet to the centerline of a brick wall! thence North along the centerline of said brick wall 82.92 feet; thence West along the north line of said Block 11, 19.40 feet to theplace of beginning. Subject to a stairway easement reserved in W. Deed heretofore and on May 1, 1920 given by Timothy Dows and Wife to H. D. Lackey, said deed being recorded in the Office of the Register of Deeds in and for Walworth County, Wis. in Vol. 161 of Deeds on Page 152.

and that the above plat is an accurate survey and a true representation thereof and correctly shows the exterior boundary lines and the location of the building on said property.

July 13, 1965

George T. Dunham, Surveyor

K & E 10-8188-880-8-84