
DUNHAM SURVEYING, S. C. SURVEYING & SUBDIVIDING DELAYAN, WISCONSIN 53115

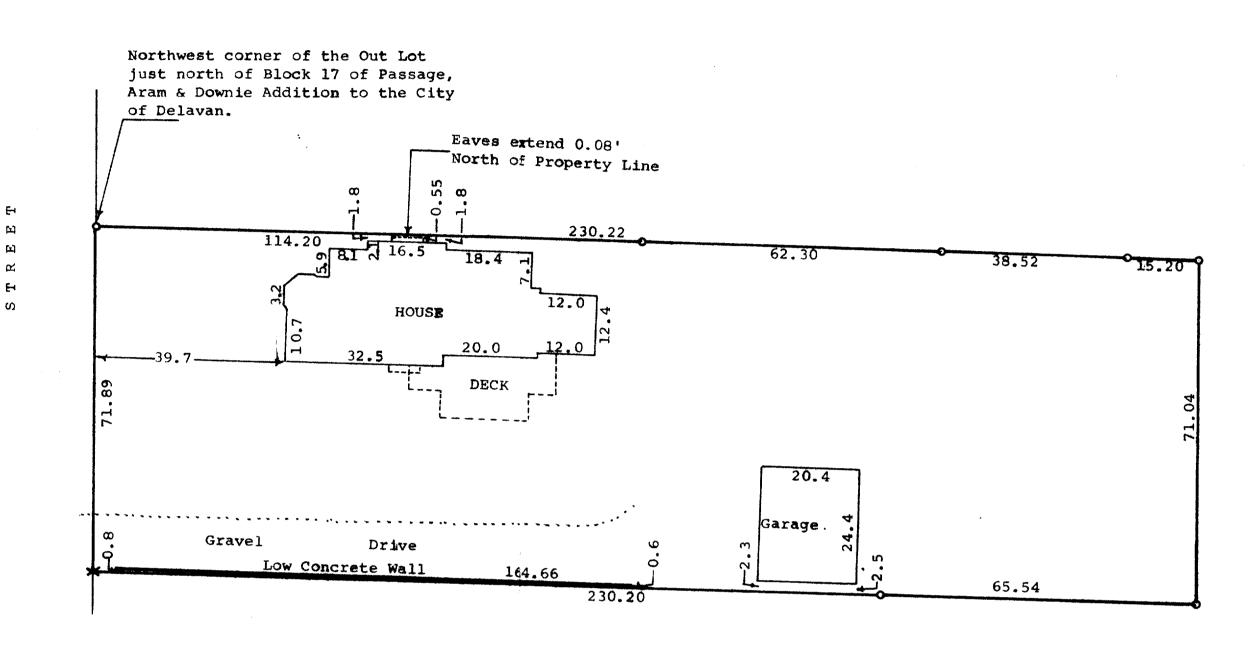

STATE OF WISCONSIN)
COUNTY OF WALWORTH)
I, George T.
described as follows,

I, George T. Dunham, Surveyor, certify that I have surveyed the property described as follows,

Beginning at the Northwest corner of the Out Lot just north of Block 17

of Passage, Aram, & Downie Addition to the City of Delavan, Walworth County, Wisconsin; thence Southerly along the east line of Eighth Street 71.89 feet (recorded as 72 feet); thence Easterly 230.20 feet (recorded as 230 feet 8 inches) to an iron pipe; thence Northerly 71.04 feet (recorded as 72 feet); thence Westerly 230.22 feet to the place of beginning. and the above map is a true representation thereof and shows the size and location of theproperty, its exterior boundaries, the location and dimensions of all structures thereon, fences, apparent easements and roadways and visible encroachments,


if any.

This survey is made for the exclusive use of the present owners of the property, and also those who purchase, mortgage, or guarantee the title thereto within one (1) year from date hereof; and as to them I warrant the accuracy of said survey and

November 2, 1978

map.

George T. Dunham, Surveyor

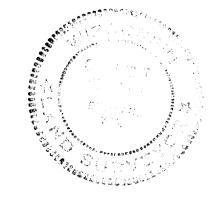

Scale - 1" = 20'
0 = Iron Fipe Found
X = Cross in Concrete

X/2/2/3/ K & R 10-9135 250-9-76