


**SURVEYING & SUBDIVIDING
DEHAVAN, WISCONSIN**

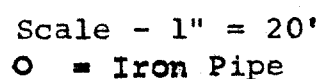

COUNTY OF WALWORTH,
I, George T. Dunham, Surveyor, certify that I have surveyed
the property described as follows,
Lot 49 and the East ½ of Lot 48 of Mar-Del Estates, a
subdivision located in the City of Delavan, Walworth County,
Wisconsin,
and that the above plat is an accurate survey and a true representation
thereof and correctly shows the exterior boundary lines and location
of the house on said property and the correct measurements thereof.
December 10, 1969

George T. Dunham
George T. Dunham, Surveyor