
GEORGE T. DUNHAM SURVEYING & SUBDIVIDING DELAYAN, WISCONSIN

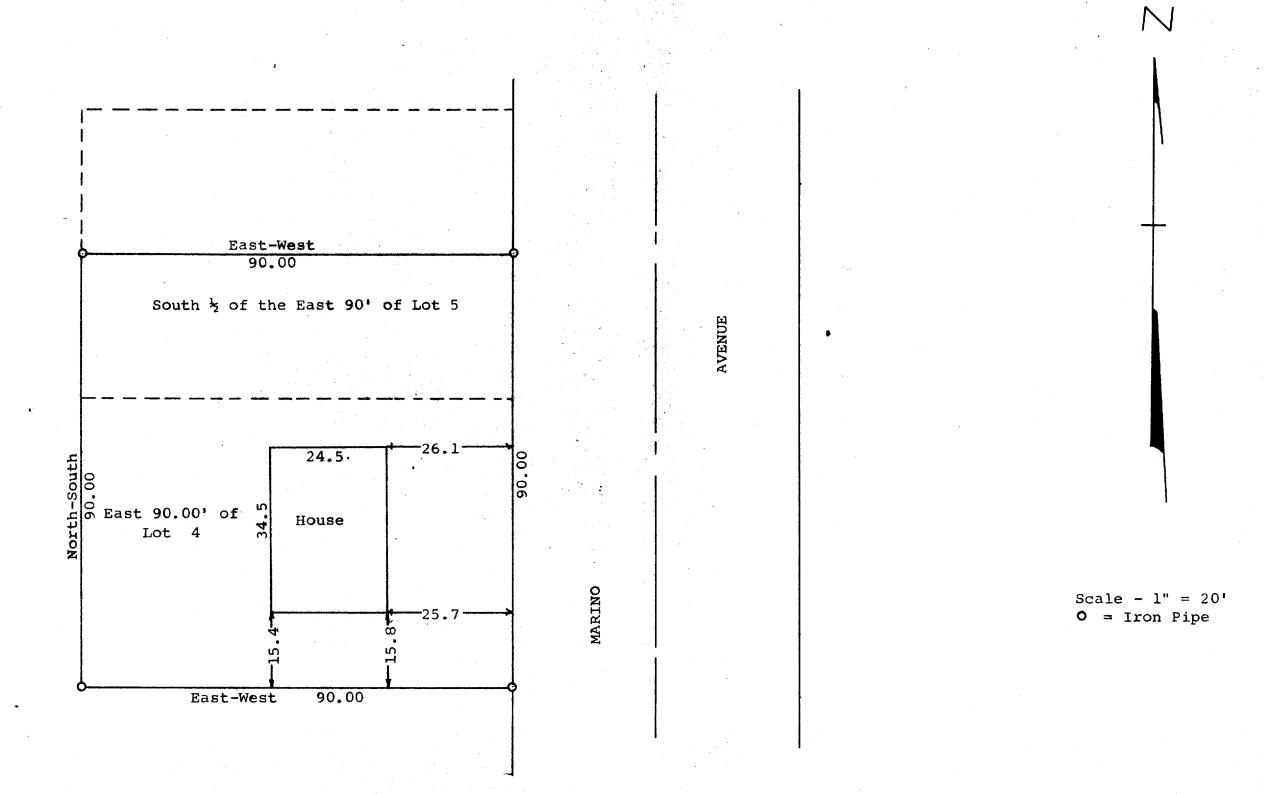

STATE OF WISCONSIN) SS COUNTY OF WALWORTH)

I, George T. Dunham, Surveyor, certify that I have

surveyed the property described as follows,

The East 90.00 feet of Lot 4 and the East 90.00 feet of the South 1/2 of Lot 5 in Mar-Del Estates, a subdivision located in the City of Delavan, Walworth County, Wisconsin, and that the above plat is an accurate survey and a true representation thereof and correctly shows the exterior boundary lines and location of the house on said property and the correct measurements thereof.

December 10, 1969

George T. Dunham, Surveyor

XMD-4A

K & E 10-7155 250-5-68