
PLAT OF SURVEY

DESCRIPTION: The North 50.00 feet of Lots 9 and 10 in Block 4 of Converse's Subdivision in the City of Delavan, a part of the N 1/2 of Section 17, Township 2 North, Range 16 East of the Fourth Principal Meridian in Walworth County, Wisconsin, recorded in Volume 544 of Deeds, Page 349.

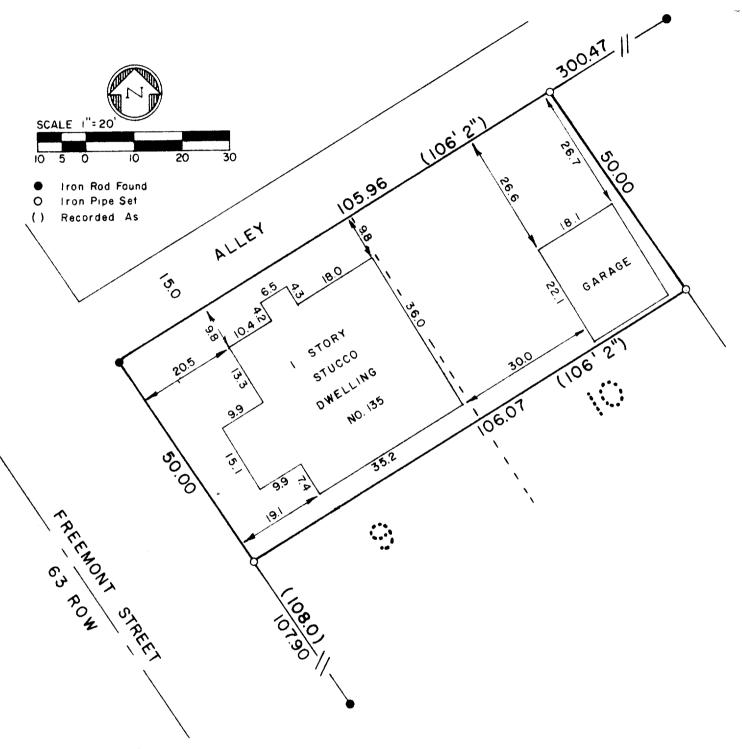

SURVEYOR'S CERTIFICATE

I have surveyed the above described property and the above map is a true representation thereof and shows the size and location of the property, its exterior boundaries, the location and dimensions of all visible encroachments. This survey is made for the exclusive use of the present owners of the property, and also those who purchase, mortgage, or guarantee the title thereto within one (1) year from datasette hereof and as to them I warrant the accuracy of said survey and map.

Date <u>Gune</u> 30, 1978

Dennis W. Valentine, B. 1416 NTINE
5-1419
HARVARD. HL.

Part XCS-34

SUR

VALENTINE AND ASSOCIATES, INC.
DELAVAN, WISCONSIN

Prepared For

DUANE DUESTERBECK
DELAVAN, WISCONSIN

Date Person Services Number 6/30/78 | of |

Job Number 7868 | file