


SURVEYING & SUBDIVIDING  
DELAN, WISCONSIN 53115

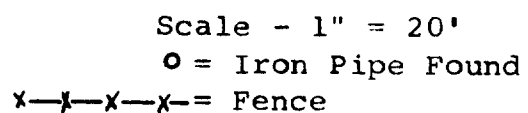

I, George T. Dunham, Surveyor, certify that I have surveyed the property described as follows.

This survey is made for the exclusive use of the present owners of the property, and also those who purchase, mortgage, or guarantee the title thereto within one (1) year from date hereof; and as to them I warrant the accuracy of said survey and map.

January 12, 1979

A circular seal for George T. Dunham, a Wisconsin Land Surveyor. The outer ring contains the text "WISCONSIN" at the top and "LAND SURVEYOR" at the bottom, separated by two five-pointed stars. The center of the seal contains the name "GEORGE T. DUNHAM" in a larger font, with "DELAVAN, WIS." in a smaller font below it. The entire seal is enclosed in a double-lined circular border.