


GEORGE T. DUNHAM
SURVEYING & SUBDIVIDING
DELAVER, WISCONSIN

GENEVA STREET

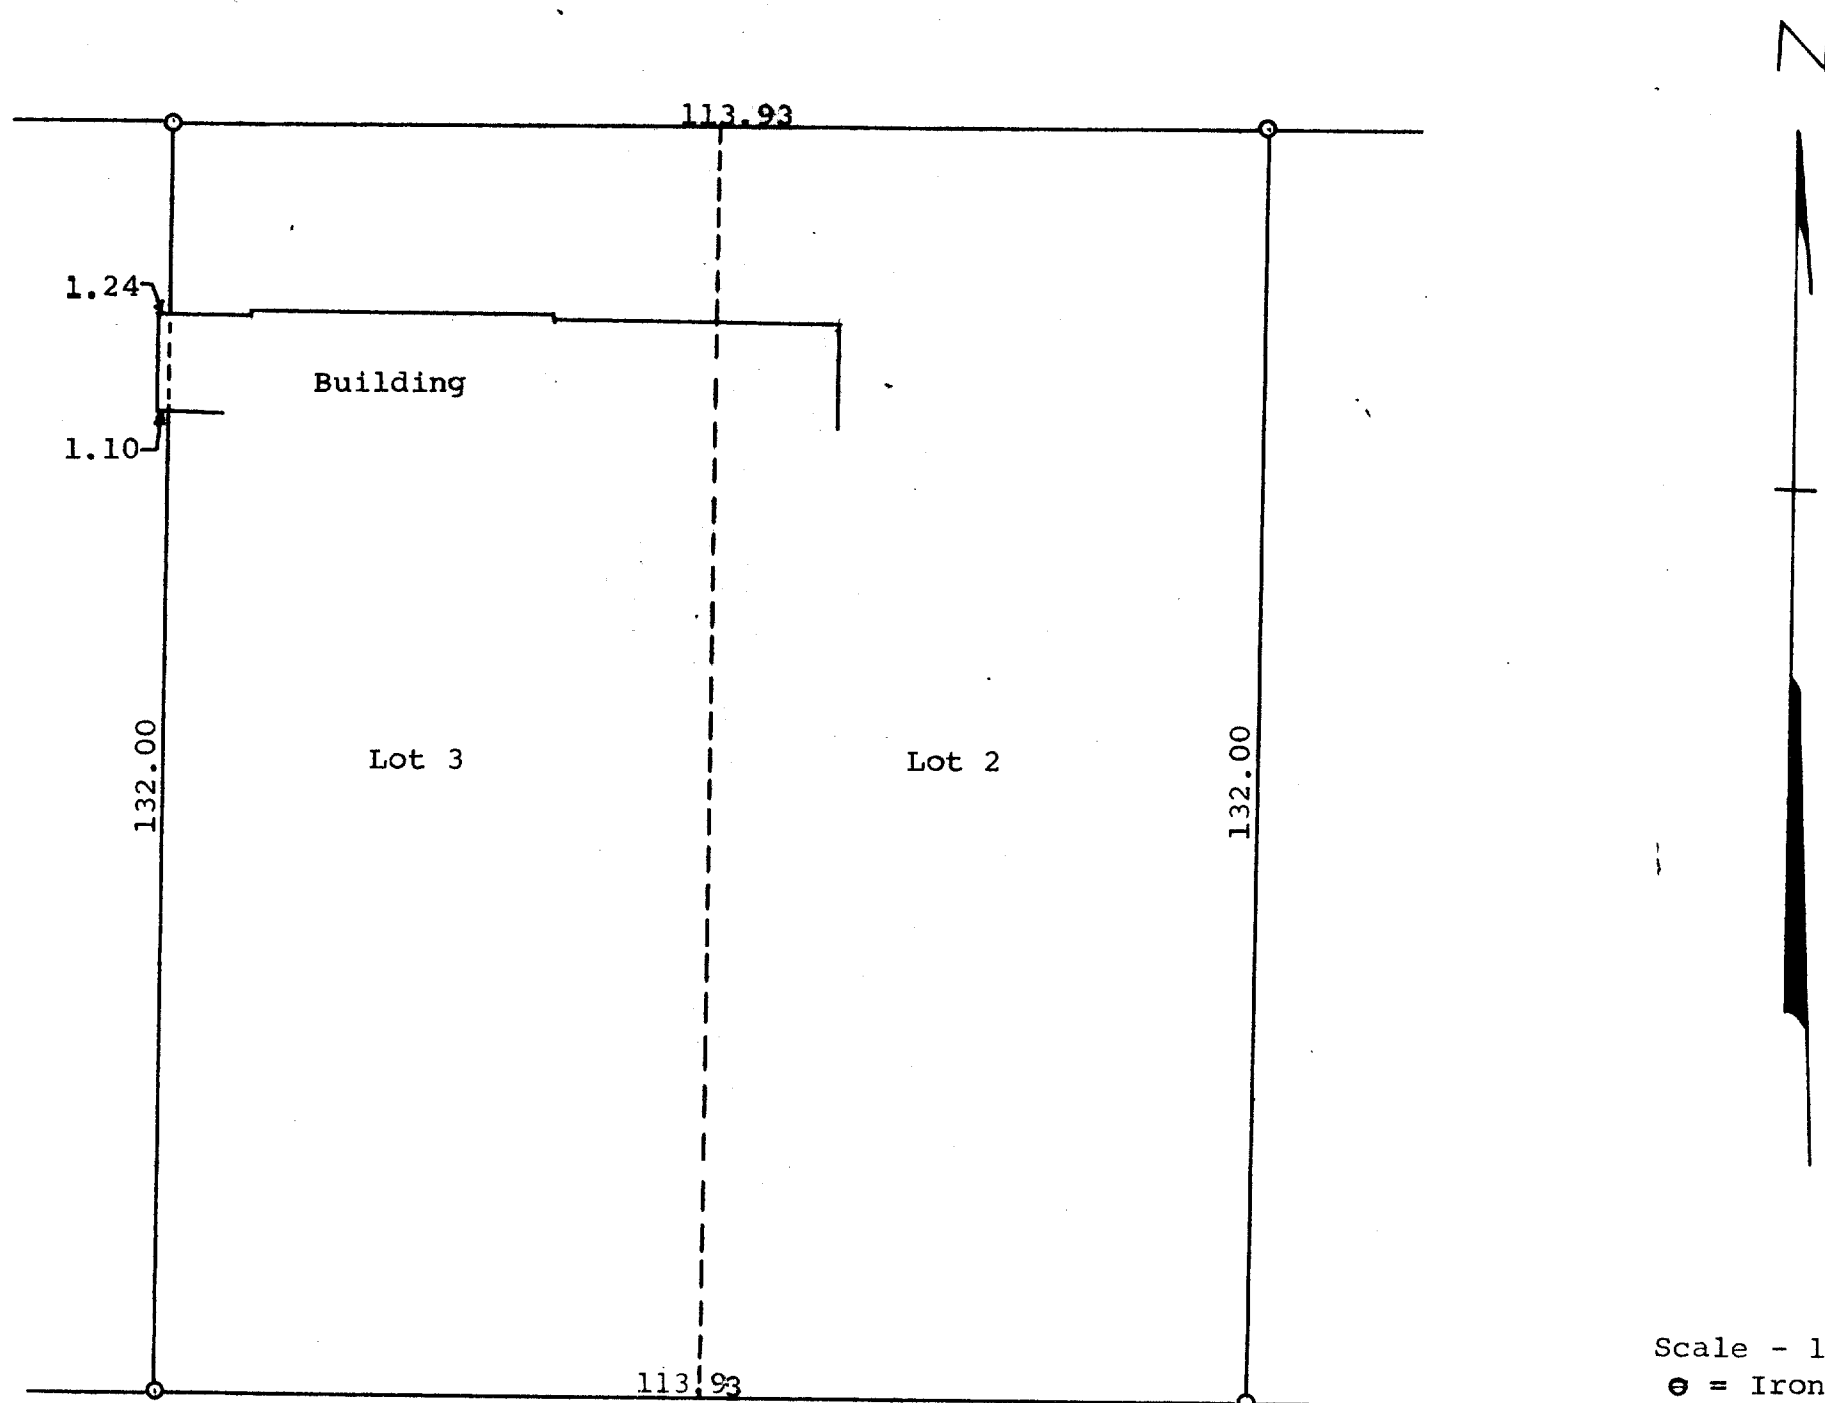

Scale - 1" = 20'
● = Iron Pipe

STATE OF WISCONSIN)
COUNTY OF WALWORTH) SS

I, George T. Dunham, Surveyor, certify that I have surveyed the property described as follows,
Lots 2 and 3 in Block 2 of Fairview Heights Addition
to the City of Delavan, Walworth County, Wisconsin,
and that the above plat is an accurate survey and a true representation thereof and correctly shows the exterior boundary lines and the correct measurements of the encroachment on Lot 4 in said subdivision.
March 23, 1970

George T. Dunham
George T. Dunham, Surveyor