
GEORGE T. DUNHAM

SURVEYING & SUBDIVIDING DELAVAN, WISCONSIN

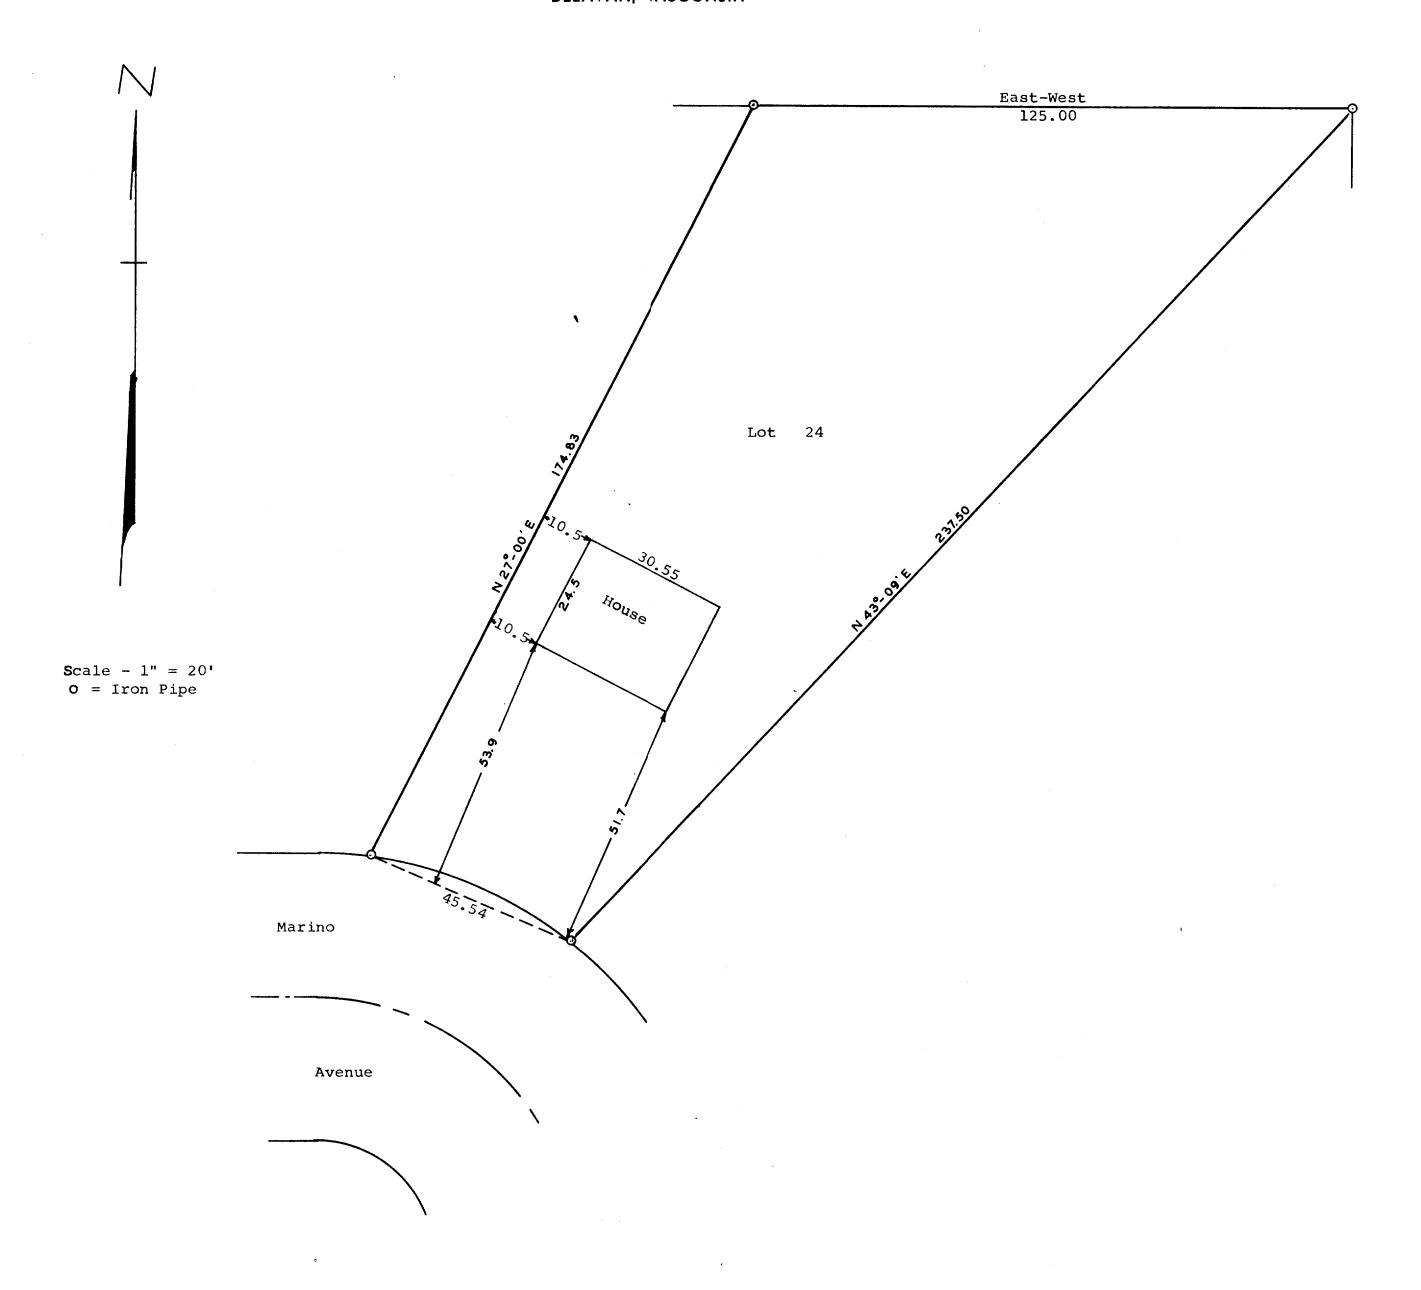

STATE OF WISCONSIN) SS COUNTY OF WALWORTH)

I, George T. Dunham, Surveyor, certify that I have

surveyed the property described as follows,

Lot 24 of Mar-Del Estates, a subdivision located in the City of Delavan, Walworth County, Wisconsin, and that the above plat is an accurate survey and a true representation thereof and correctly shows the exterior boundary lines and location of the buildings on said property and the correct measurements thereof

December 10, 1969

K&E 10-7155 250-10-69